

PLAT AND RECORD

COUNTY BUILDING
CITY OF JANESVILLE

V-4 141
#179 BELOIT REC
12/8/75 DAB

Of a Survey on Section 28 & 29 T 3 R 14 E. of the 4 P. M. in JOHNSTOWN Township

Rock County, Wisconsin, made MAY the 31st 1962


I hereby certify that the following is a correct record of said survey as made by me.

MICROFILMED

R. B. Stump

County Surveyor.

THE GEO. F. SARGENT COMPANY, ST. LOUIS

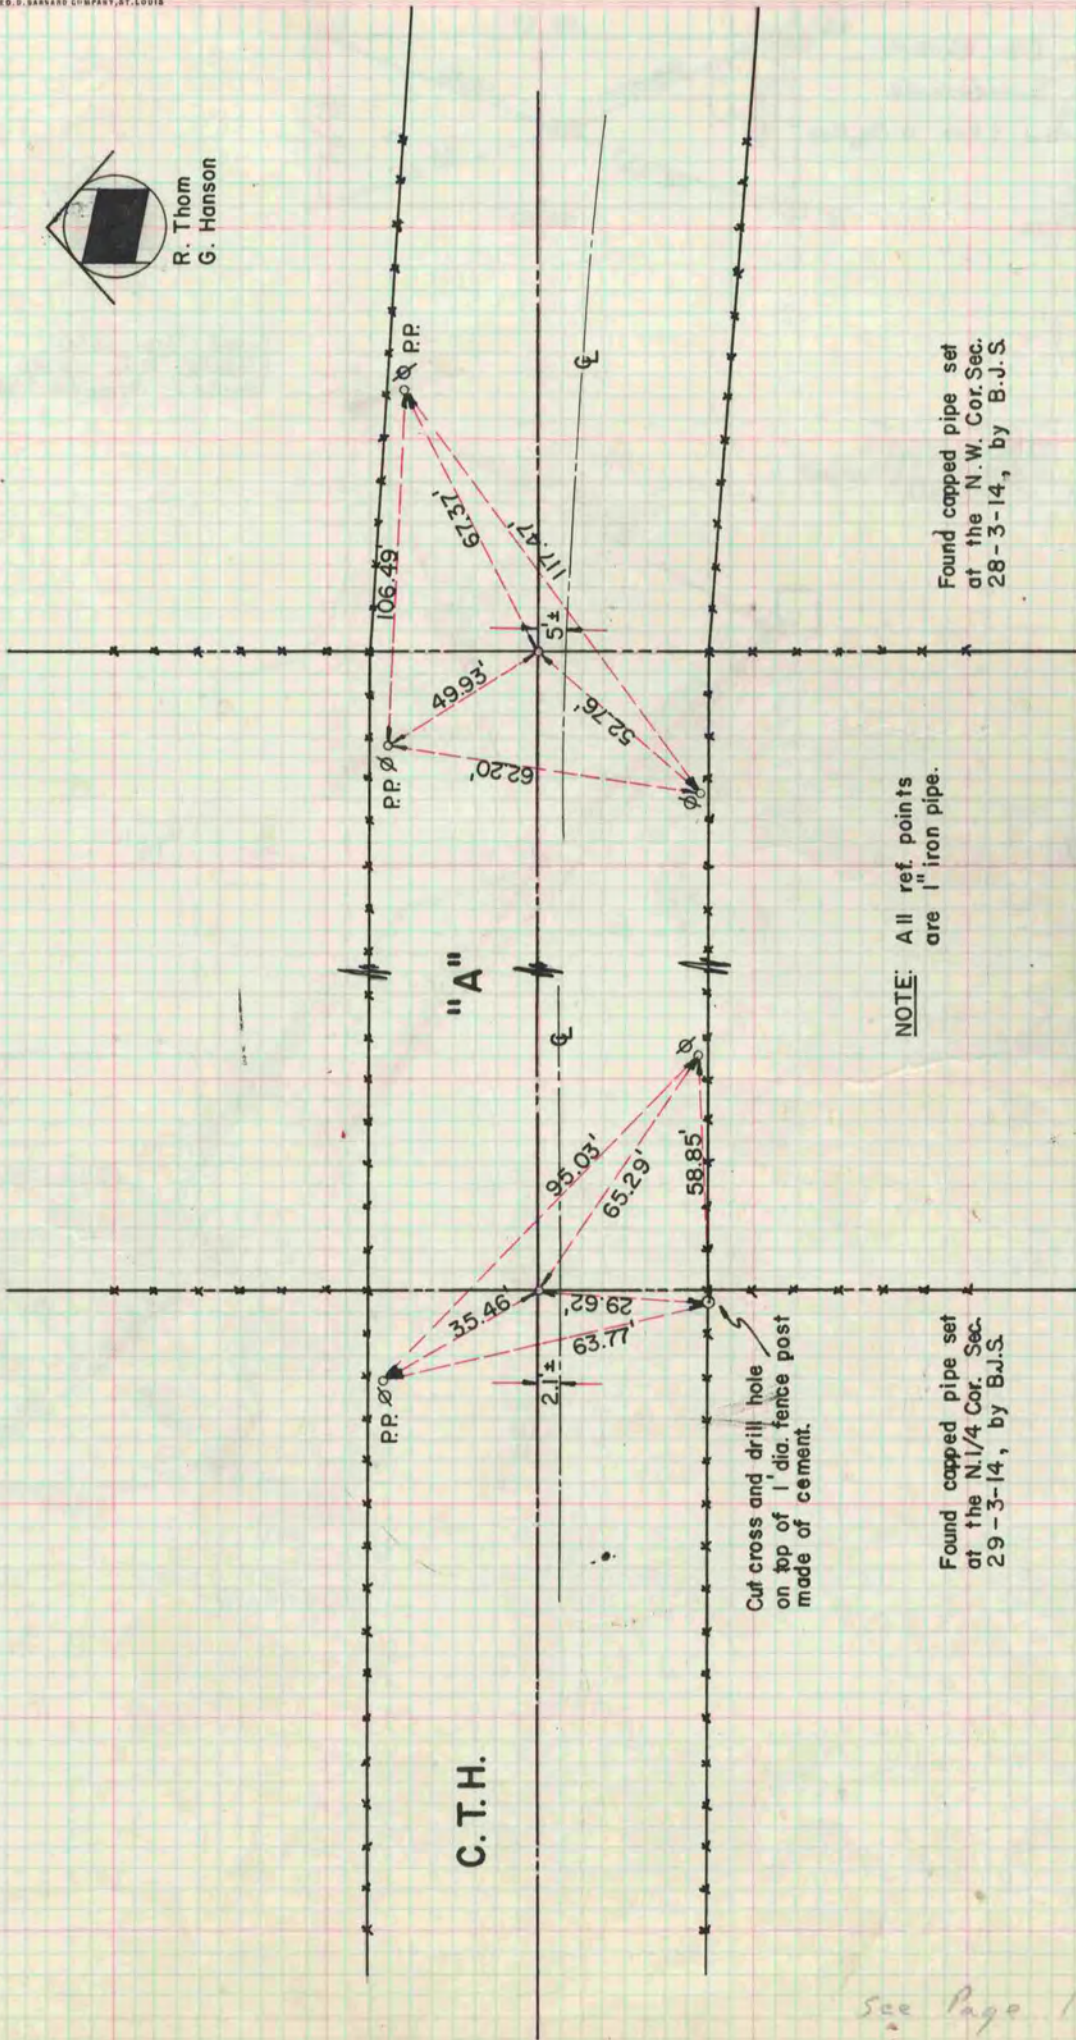

NOTE: All ref. points are 1" iron pipe.

Found capped pipe set at the N.E. 1/4 Cor. Sec. 29-3-14, by B.J.S.

Found capped pipe set at the N.W. Cor. Sec. 28-3-14, by B.J.S.

Cut cross and drill hole on top of 1" dia. fence post made of cement.

See Page 179 Beloit