

PLAT AND RECORD

117
Vf4

COUNTY BUILDING
CITY OF JANESVILLE

Of a Survey on Section 31 T 1 R 12 E. of the 4 P. M. in BELOIT Township


Rock County, Wisconsin, made APRIL the 8th 1963

I hereby certify that the following is a correct record of said survey as made by me.

MICROFILMED

R. B. Hoffman

County Surveyor.

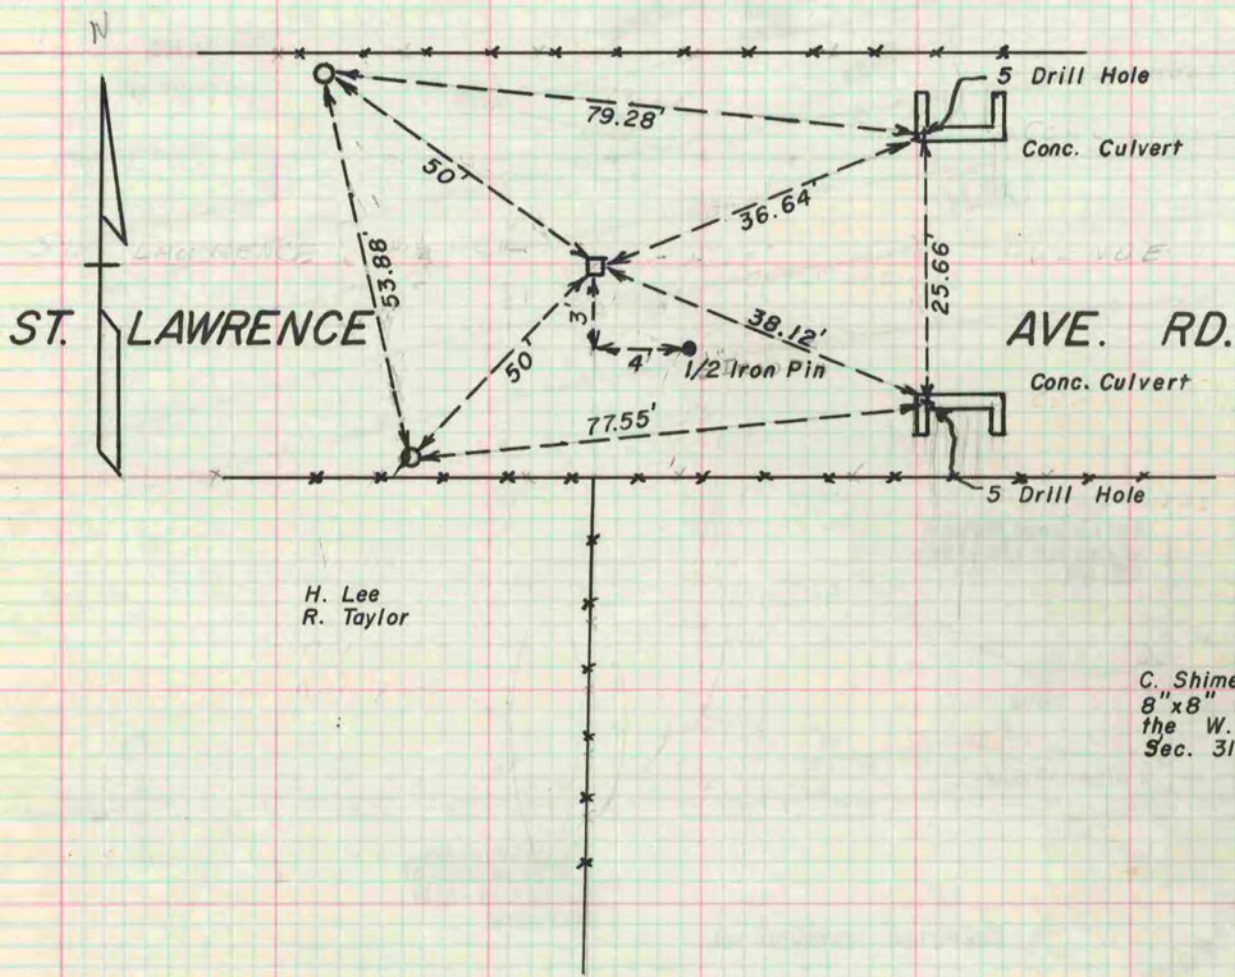

SEE PAGE 6