

MICROFILMED

# PLAT AND RECORD

141

V-1

COUNTY BUILDING  
CITY OF JANESVILLE


Of a Survey on Section 15 T 2 R 13 E. of the 4 P. M. in La Prairie Township

Rock County, Wisconsin, made Oct. the 6<sup>th</sup> 1860

I hereby certify that the following is a correct record of said survey as made by me.

(Signed) Edward Roger  
R.H.B. County Surveyor.

The Corners on the West side of Sec 15 are the same as those given on East side of Sec. 16 opposite page.

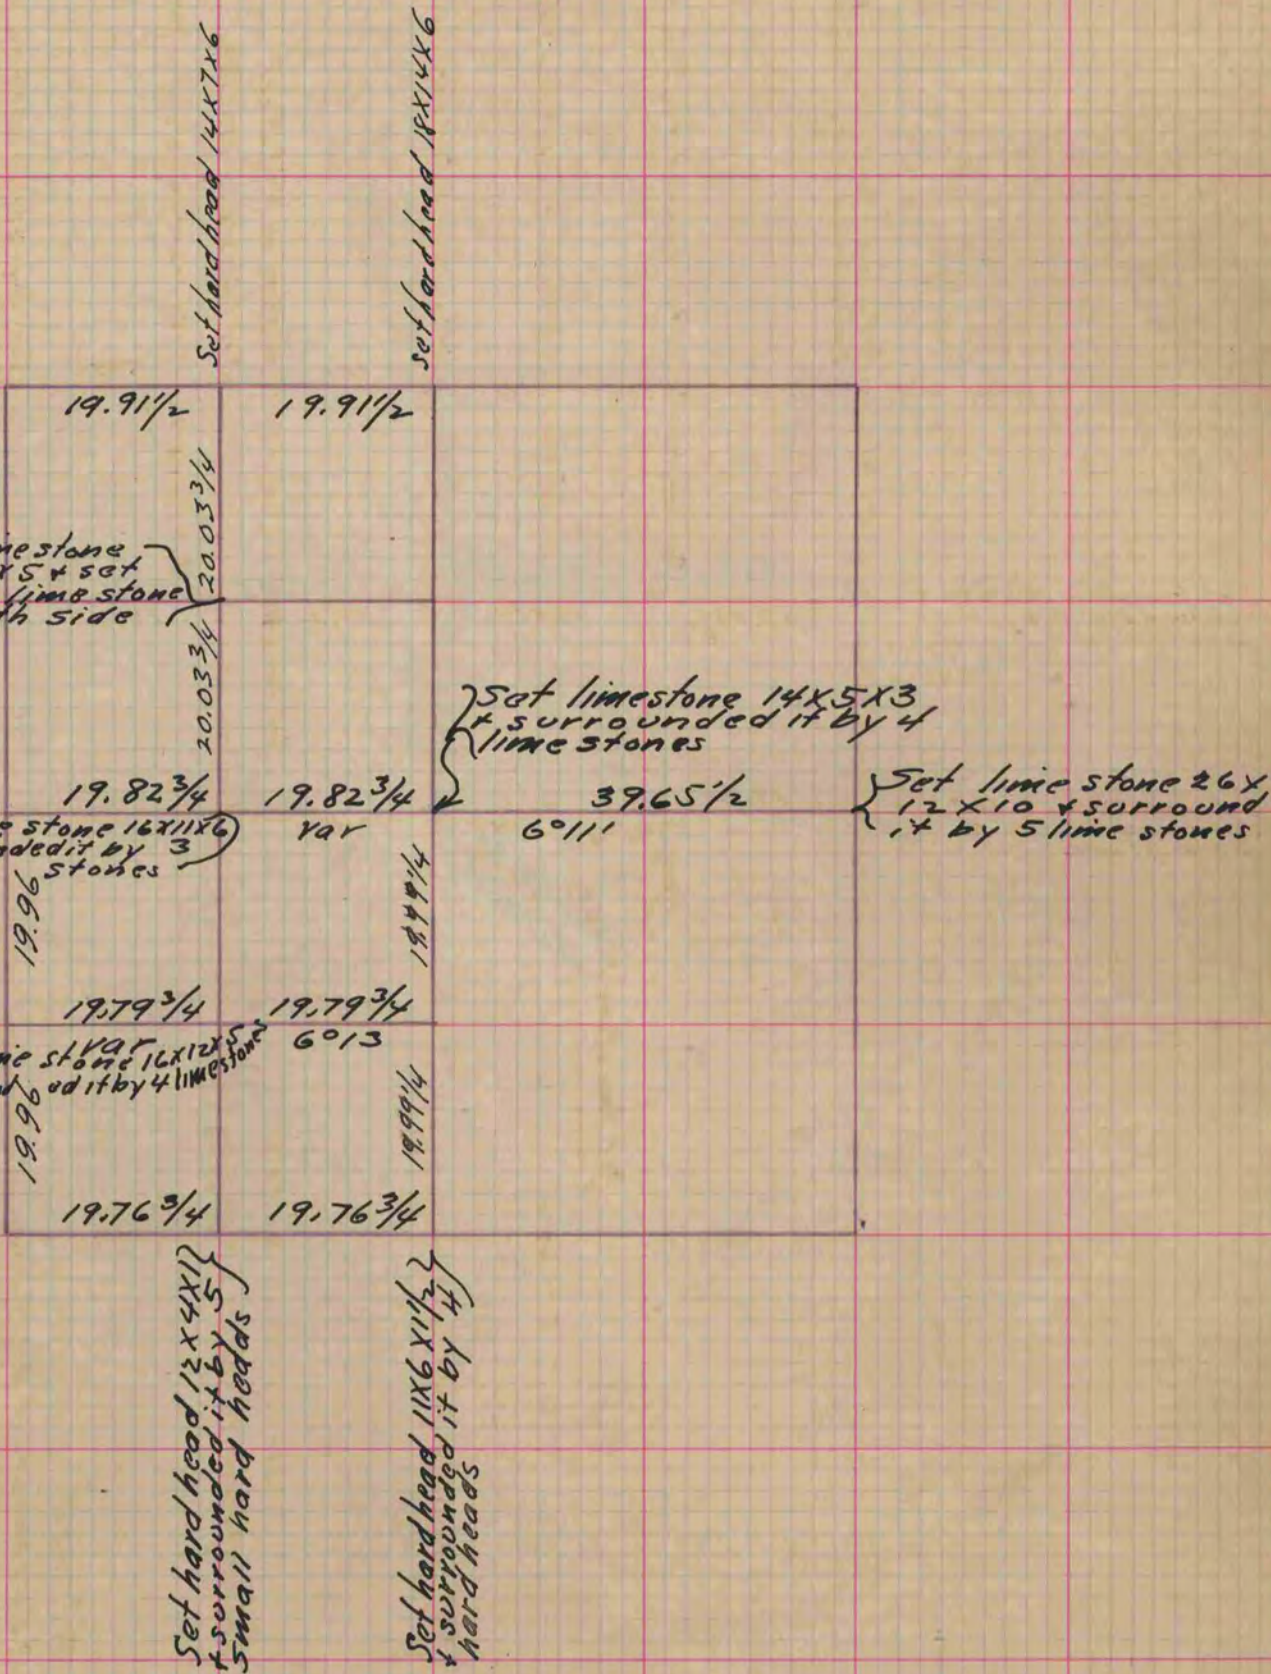

Copied from Page 150 Vol. 1. Original County Surveyors Record.