

# PLAT AND RECORD

COUNTY BUILDING  
CITY OF JANESVILLE

COUNTY BUILDING  
CITY OF JANESVILLE


Of a Survey on Section 18 T. 1 N. R. 12 E. of the 4 P. M. in BELOIT Township

Rock County, Wisconsin, made OCTOBER the 13th 1960

I hereby certify that the following is a correct record of said survey as made by me.

County Surveyor.

**MICROFILMED**

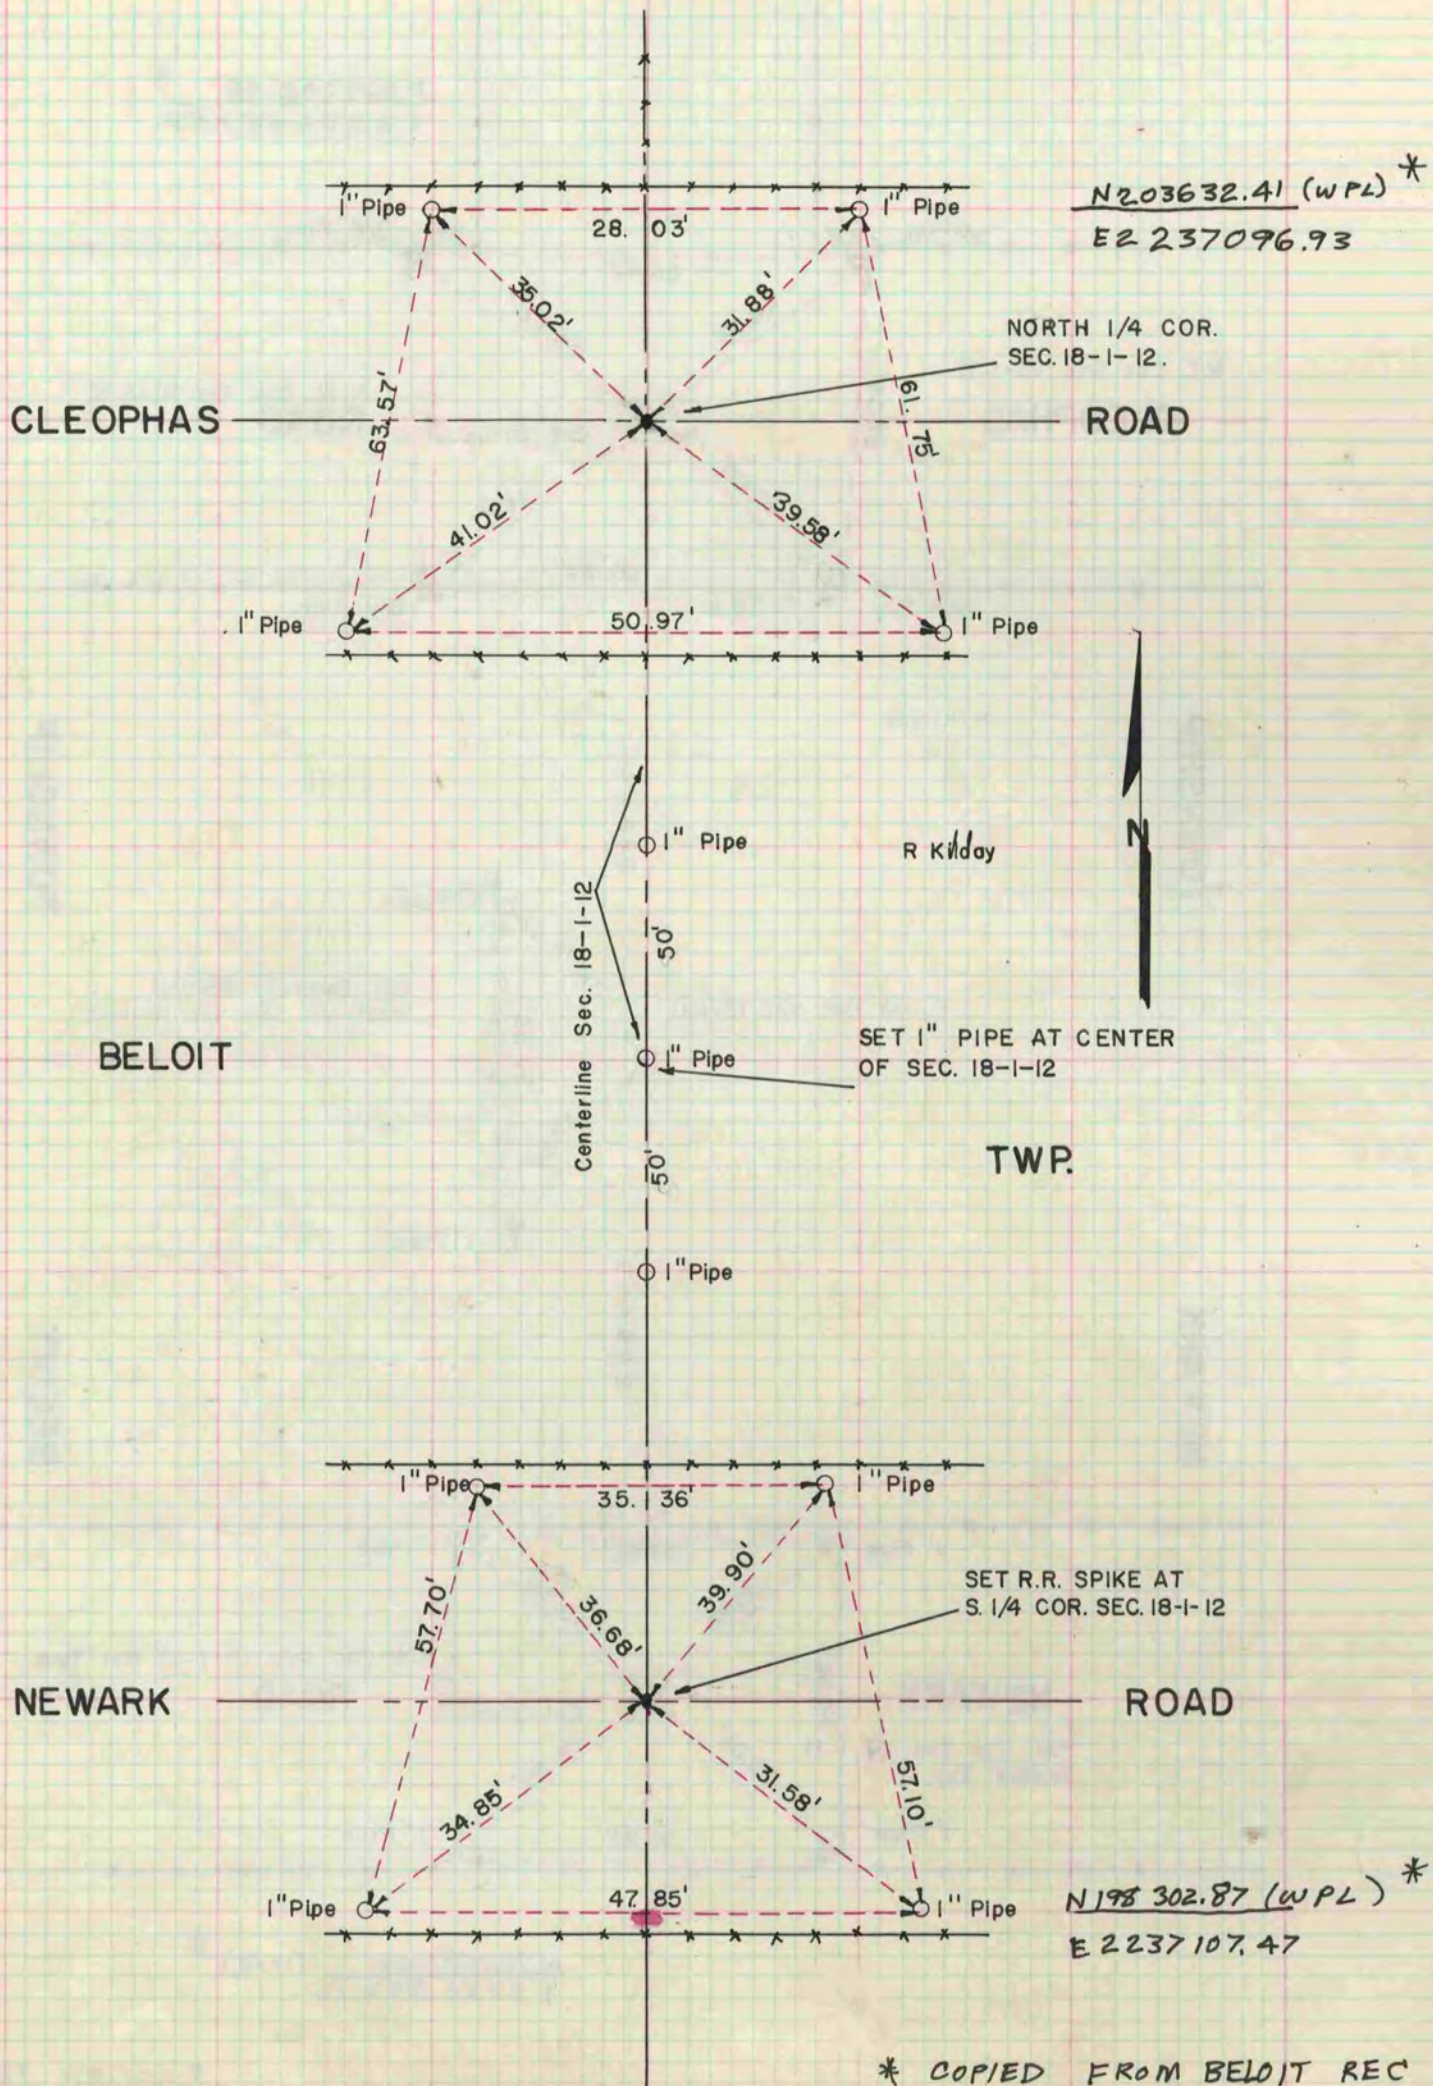

\* COPIED FROM BELOIT REC  
12/8/75 DAB