

PLAT AND RECORD


MICROFILMED

COUNTY BUILDING
CITY OF JANESVILLE

Of a Survey on Section 2 T 3 R 12 E. of the 4 P. M. in Janesville Township
Rock County, Wisconsin, made March the 11th 1861

I hereby certify that the following is a correct record of said survey as made by me.

(Signed) Edward Ruger
R.H.B. County Surveyor.

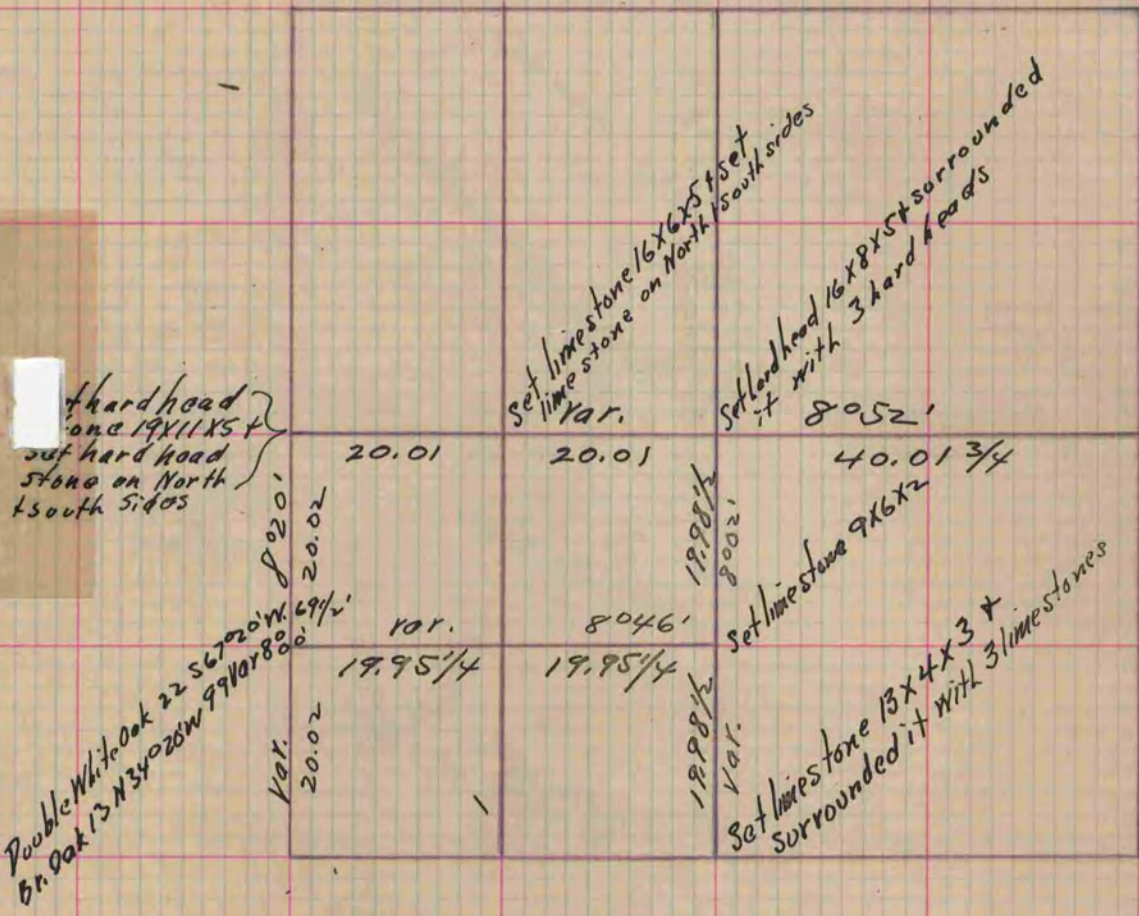

Copied from Page 162 Vol. One Original County Surveyors Record