

MICROFILMED

PLAT AND RECORD

123

✓-1


COUNTY BUILDING
CITY OF JANESVILLE

Of a Survey on Section 15 T 4 R 12 E. of the 4 P. M. in Fulton Township

Rock County, Wisconsin, made December the 24th 1859

I hereby certify that the following is a correct record of said survey as made by me.

(Signed) Edward Ruger
R.H.B. County Surveyor.

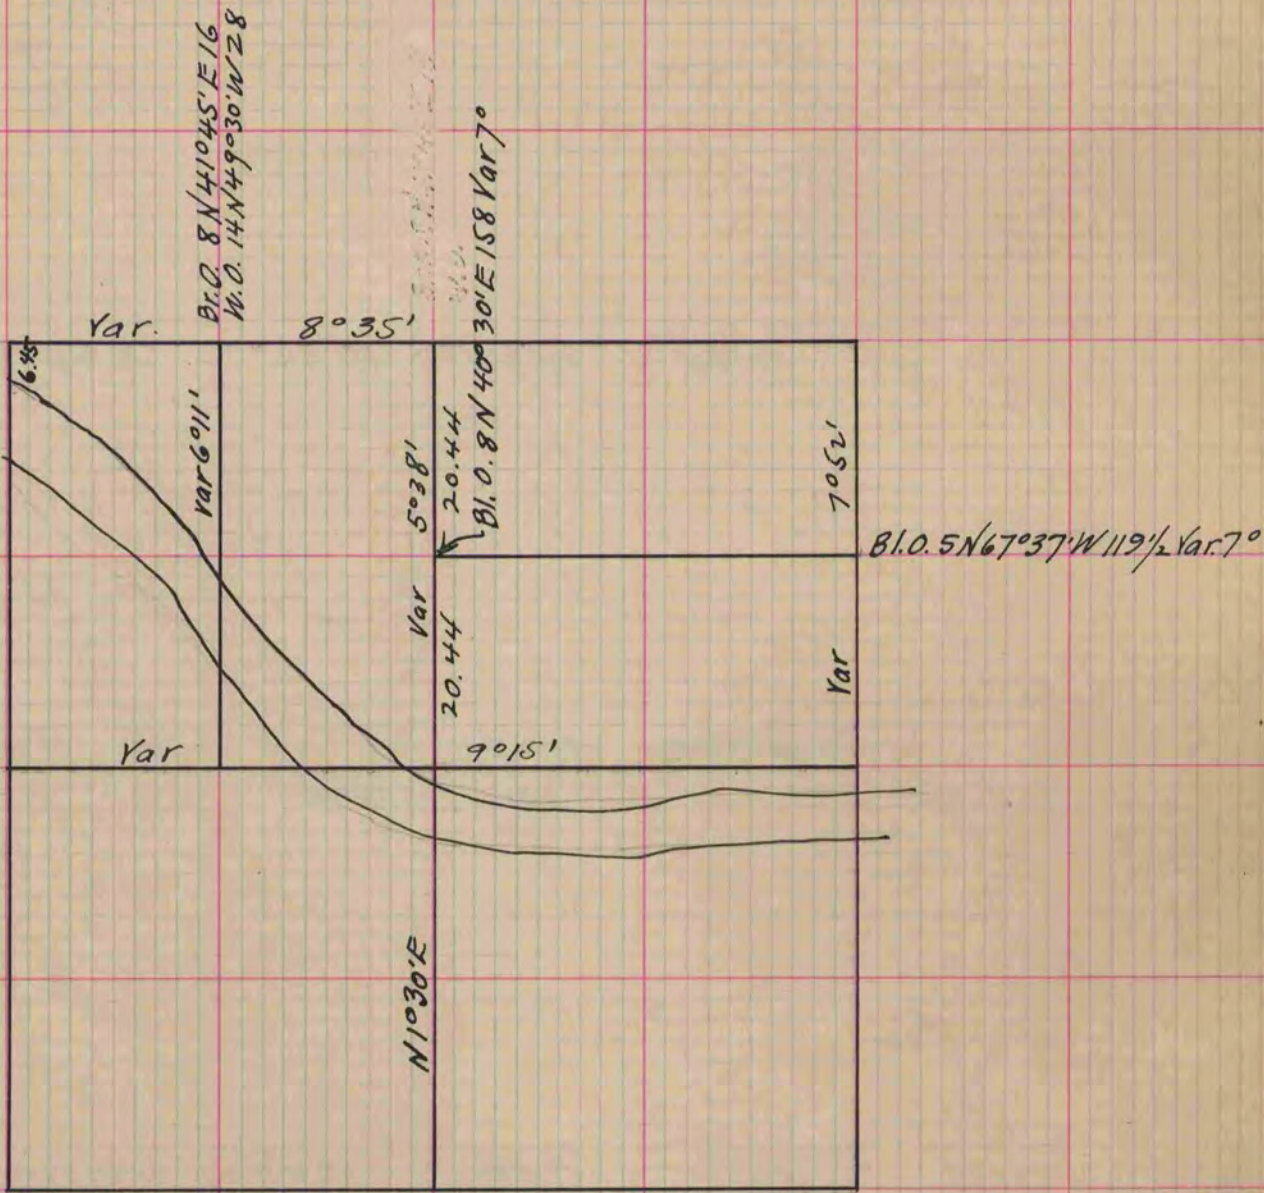

Copied from Page 132 Vol. One Original County Surveyors Record