

MICROFILMED


PLAT AND RECORD

Of a Survey on Section 23 T 2 R 14 E. of the 4 P. M. in Bradford Township
Rock County, Wisconsin, made November the 11th 1873

I hereby certify that the following is a correct record of said survey as made by me.

COUNTY BUILDING
CITY OF JANESVILLE

(Signed) Edward Ruger
R. H. B. County Surveyor.

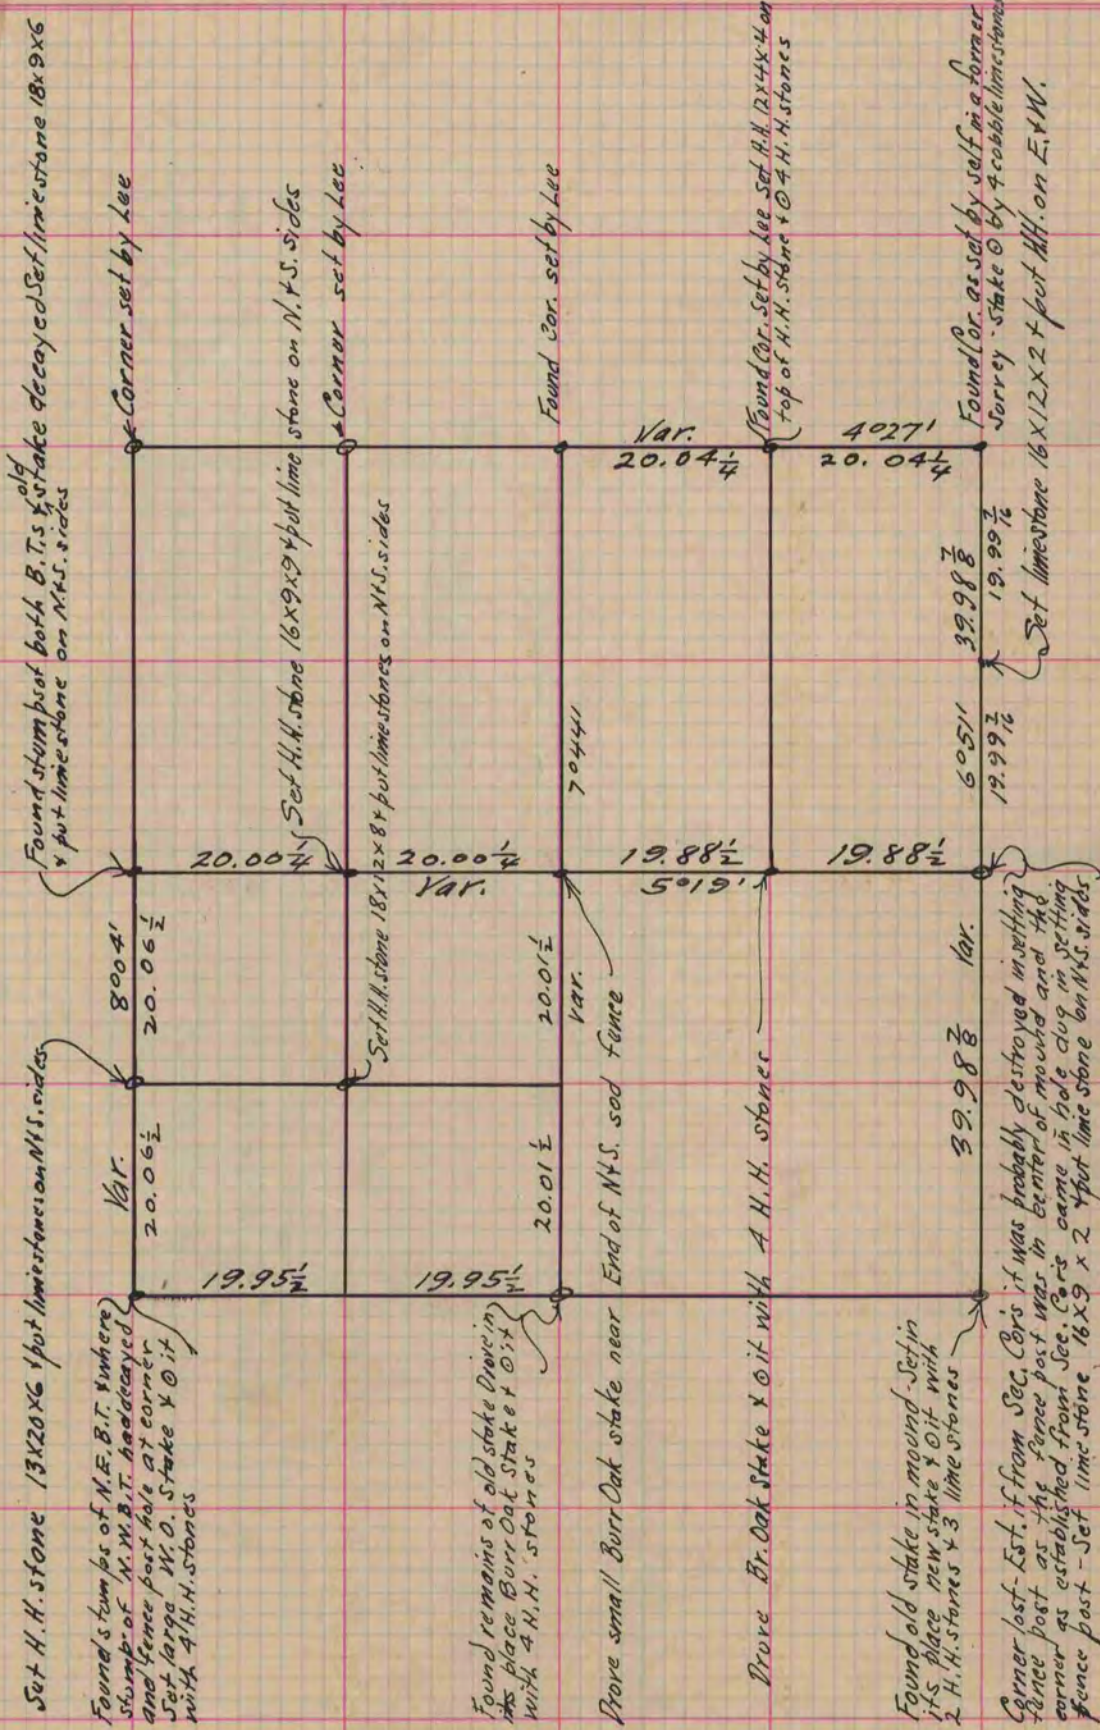

Copied from page 71 Vol. 2. Original County Surveyors Record