

PLAT AND RECORD

MICROFILMED


COUNTY BUILDING
CITY OF JANESVILLE

Of a Survey on Section 11 T 4 R 14 E. of the 4 P. M. in Lima Township

Rock County, Wisconsin, made June the 12 1876

I hereby certify that the following is a correct record of said survey as made by me.

(Signed) Edward Ruger
R.H.B. County Surveyor.

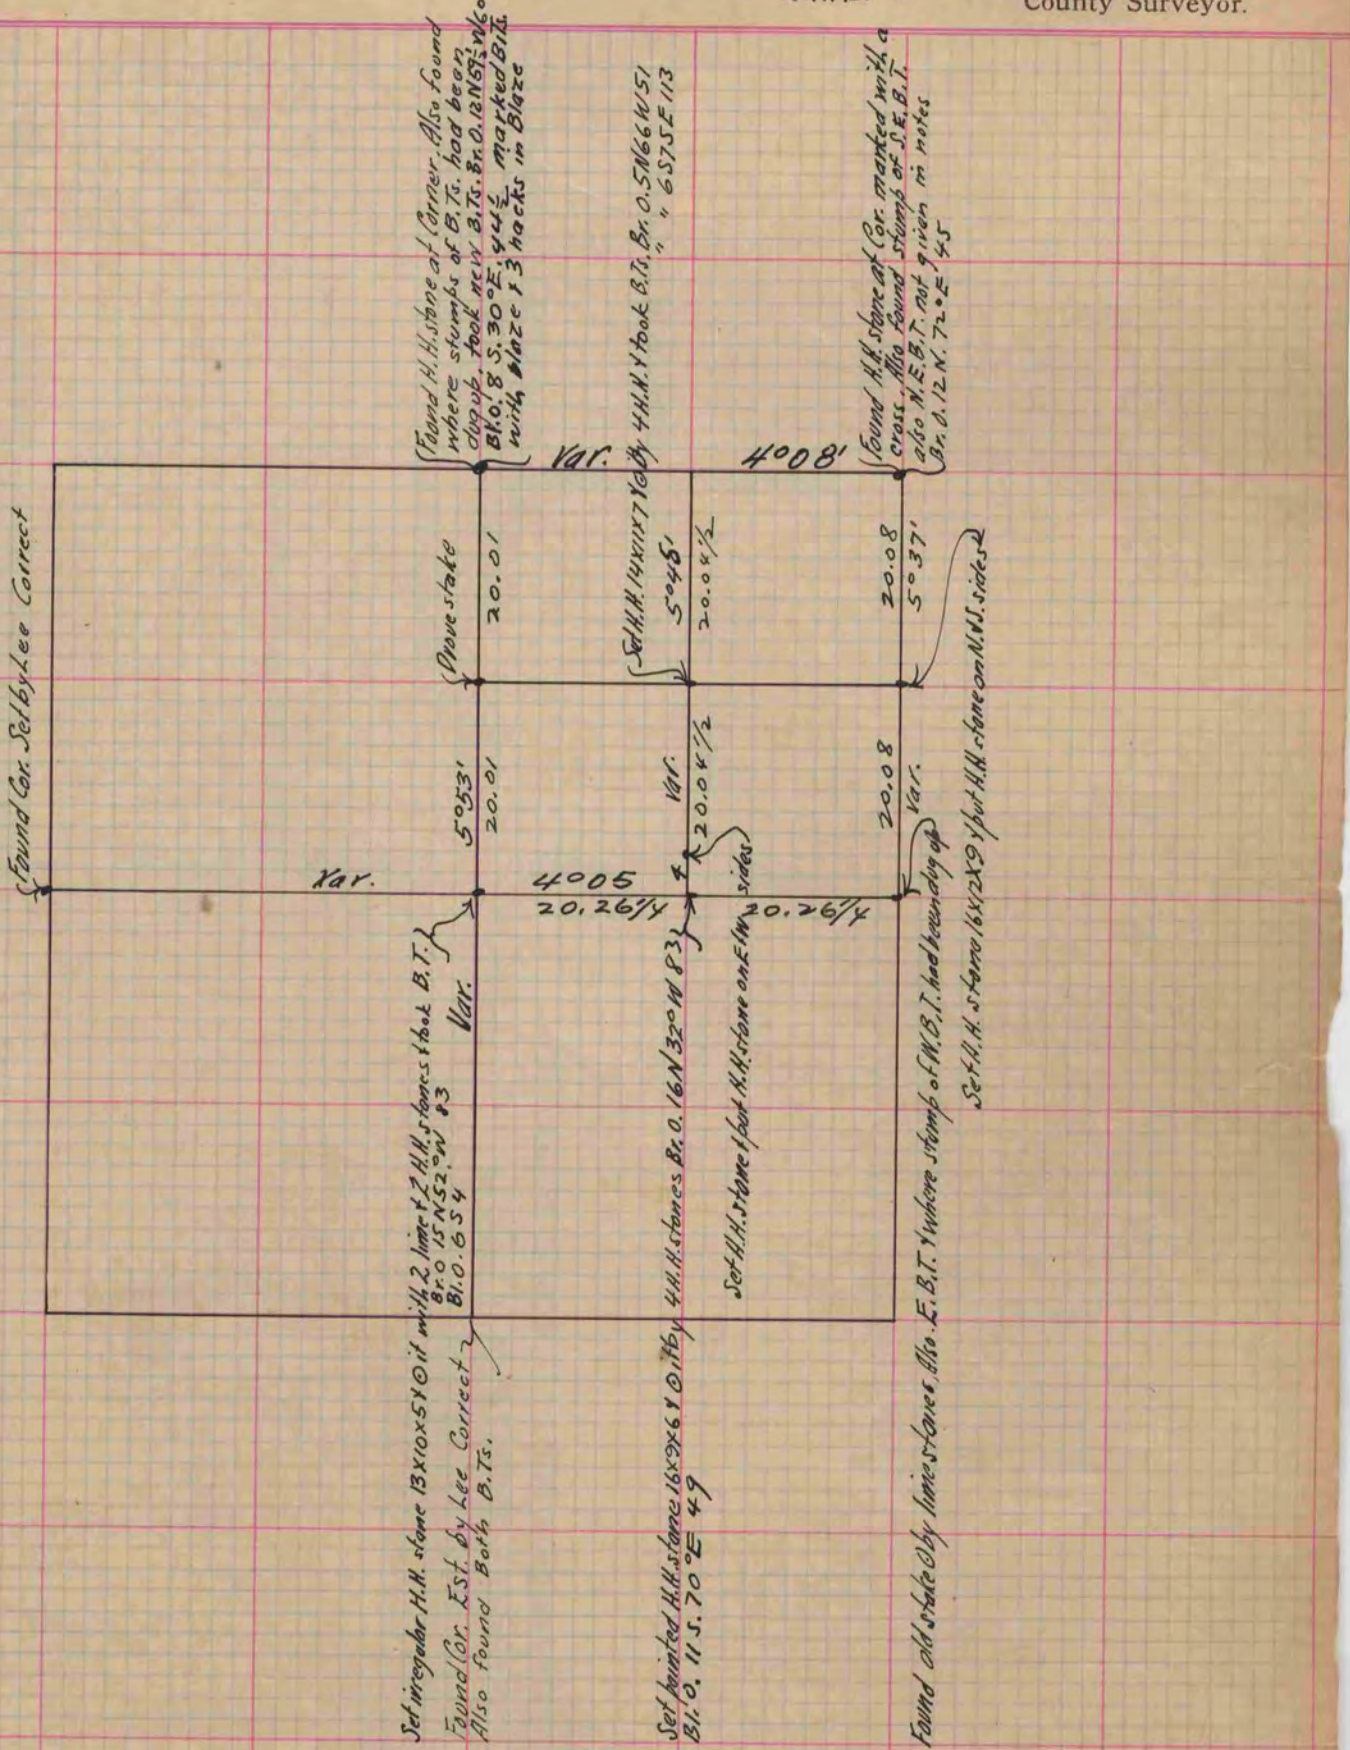

Copied from Page 165 Vol. 2 County Surveyors Record