

**MICROFILMED**

# PLAT AND RECORD

155

V-1


COUNTY BUILDING  
CITY OF JANESVILLE

Of a Survey on Section 17 T 3 R 13 E. of the 4 P. M. in Harmony Township

Rock County, Wisconsin, made March the 26<sup>th</sup> 1861

I hereby certify that the following is a correct record of said survey as made by me.

(Signed) Edward Ruger  
R. H. B. County Surveyor.

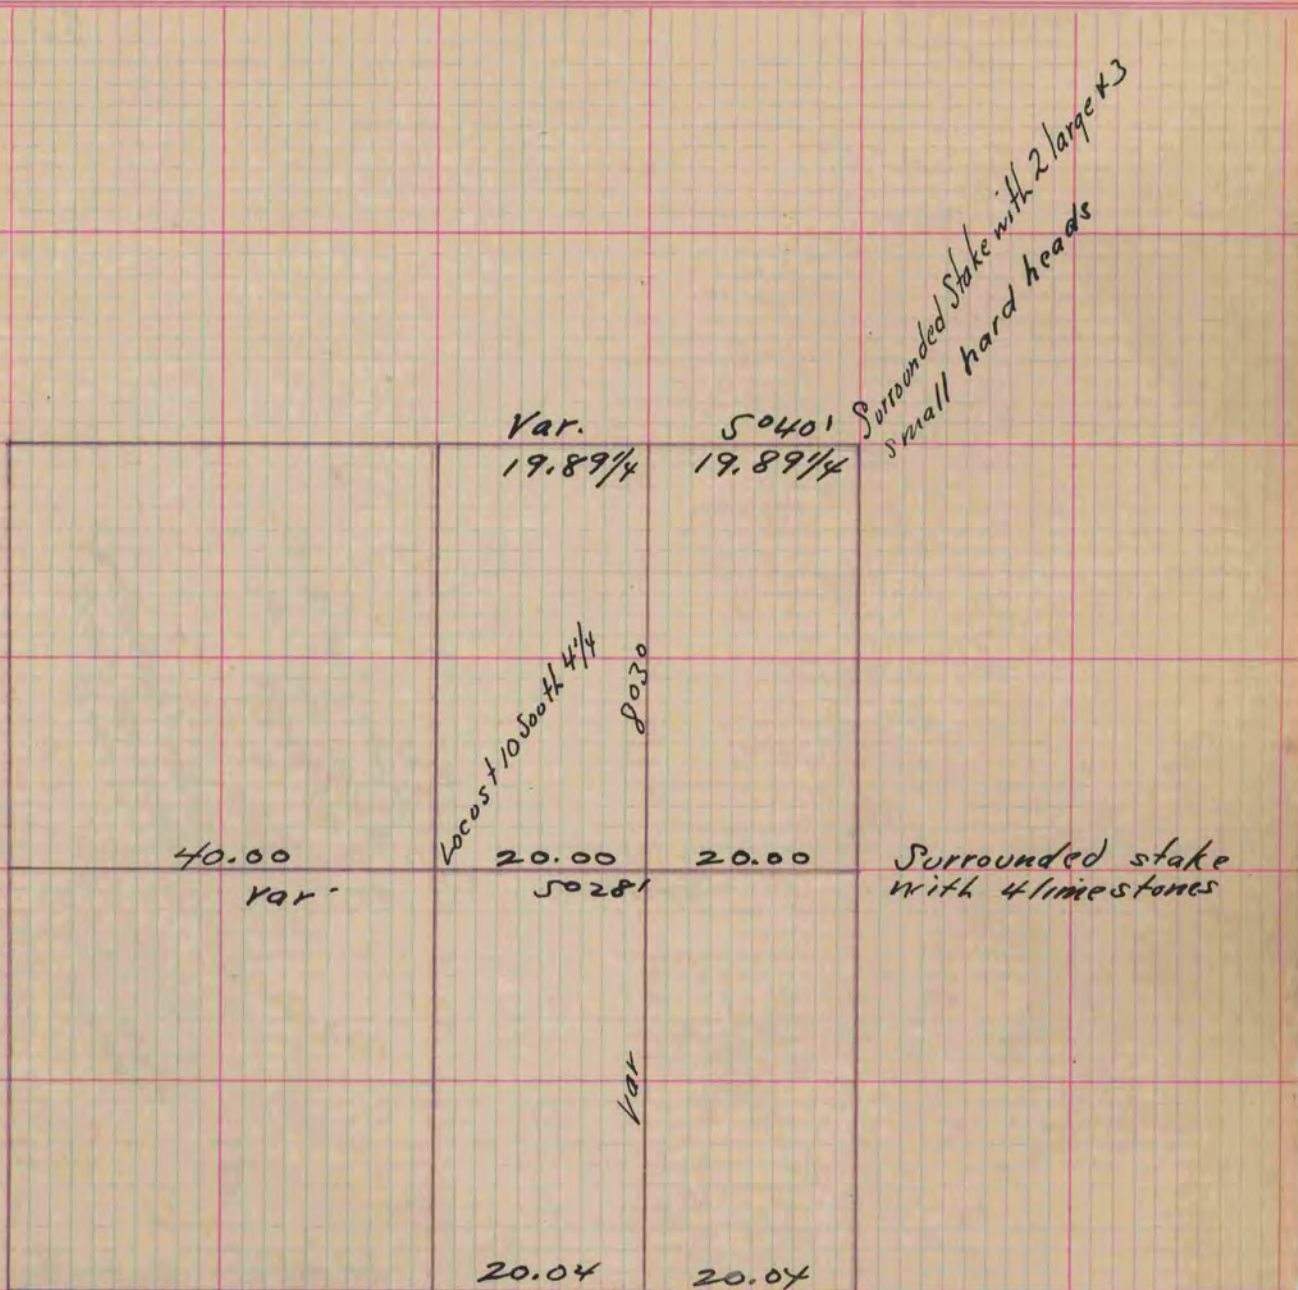

Copied from Page 164 Vol. 1. Original County Surveyors Record