

PLAT AND RECORD

51
VOL. 5

Of a Survey on Section **35 4 14** T. R. E. of the 4 P. M. in **LIMA** Township
Rock County, Wisconsin, made **DEC** the **18** 19 **78**

I hereby certify that the following is a correct record of said survey as made by me.



Donald Barnes
DONALD A. BARNES
216
JANESVILLE
WI.
COUNTY SURVEYOR

COUNTY BUILDING
CITY OF JANESVILLE
County Surveyor.

E 1/4 COR SEC 35

SET ALUM MON @ 3 H.H. AS REF IN COUNTY SURVEYORS
RECORDS VOL 4 PG 427
FD 3 H.H. & FLAT LIMESTONE

o 1 1/4" X 24" I.P.

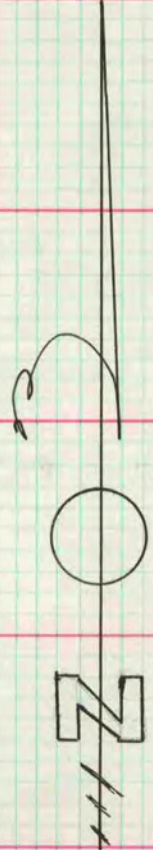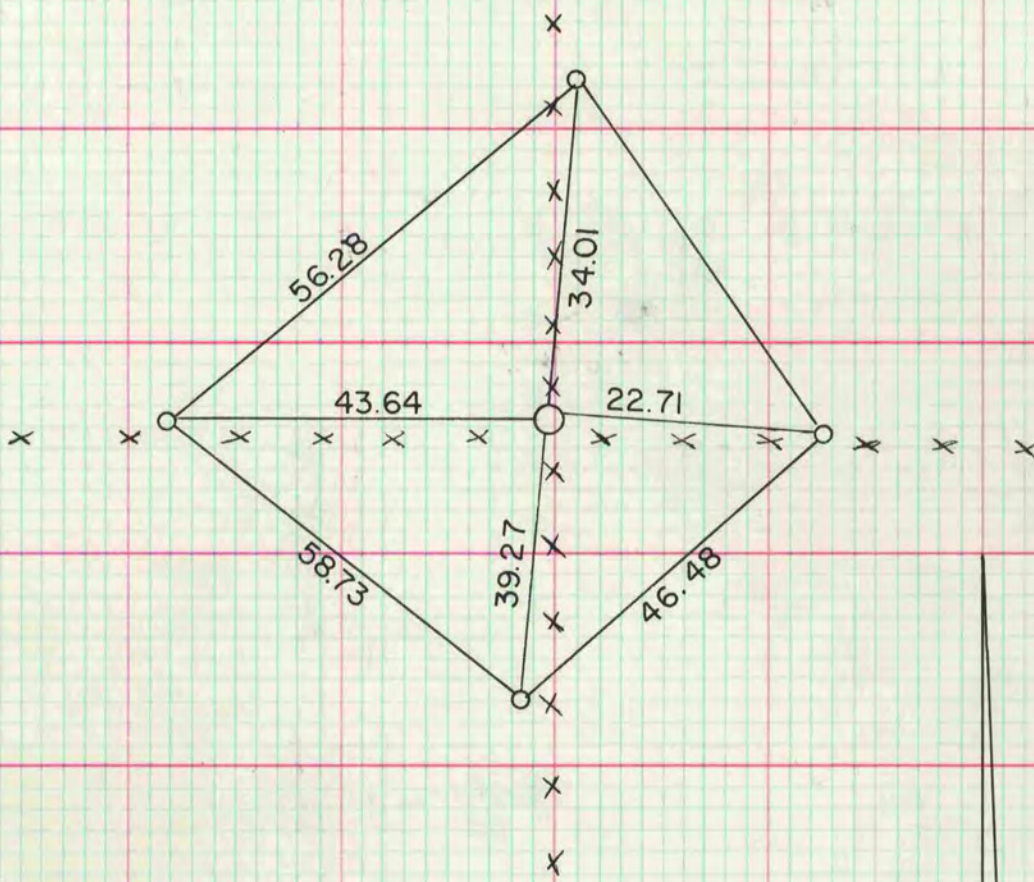

MICROFILMED