

# PLAT AND RECORD

195  
V-1

**MICROFILMED**


COUNTY BUILDING  
CITY OF JANESVILLE

Of a Survey on Section 10 T 3 R 10 E. of the 4 P. M. in Magnolia Township

Rock County, Wisconsin, made December the 10<sup>th</sup> 1863

I hereby certify that the following is a correct record of said survey as made by me.

Signed J. D. Locke  
R.H.B. County Surveyor.

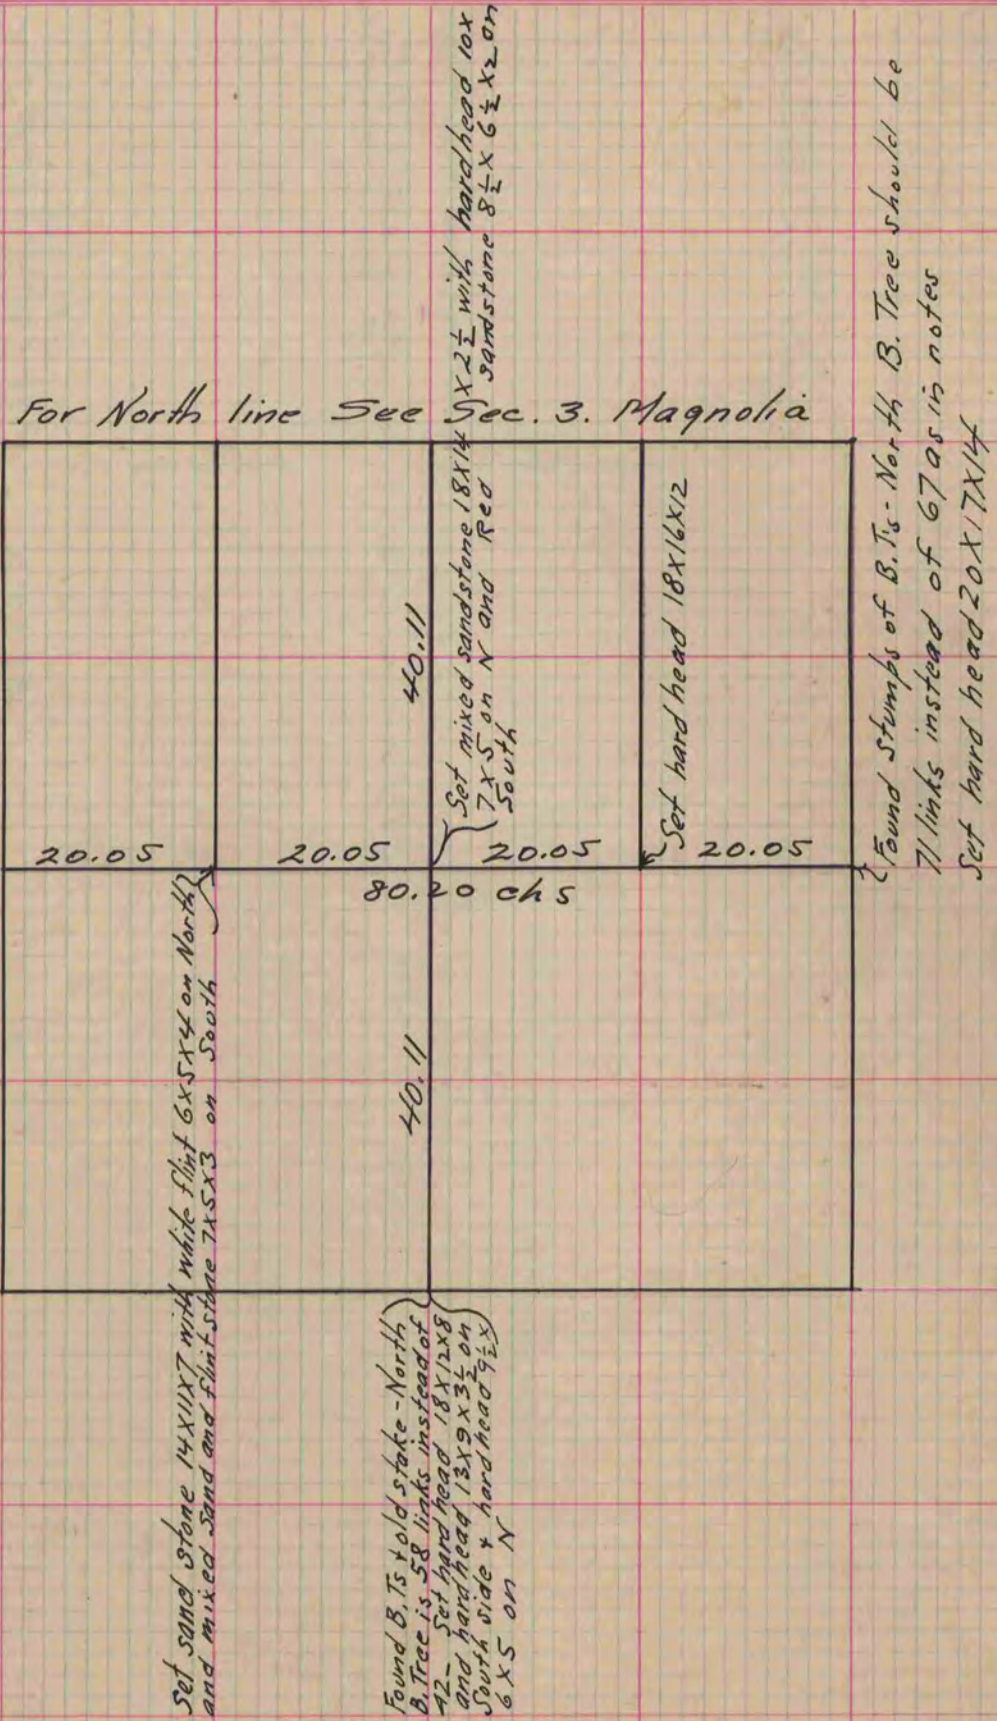

Copied from Upper 1/2 of Page 198 Vol. 1. Original County Surveyors Record