

MICROFILMED

PLAT AND RECORD

151

V-1


COUNTY BUILDING
CITY OF JANESVILLE

Of a Survey on Section 2 T 1 R 13 E. of the 4 P. M. in Turtle Township

Rock County, Wisconsin, made March the 7th 1861

I hereby certify that the following is a correct record of said survey as made by me.

(Signed) Edward Ruger
R.H.B. County Surveyor.

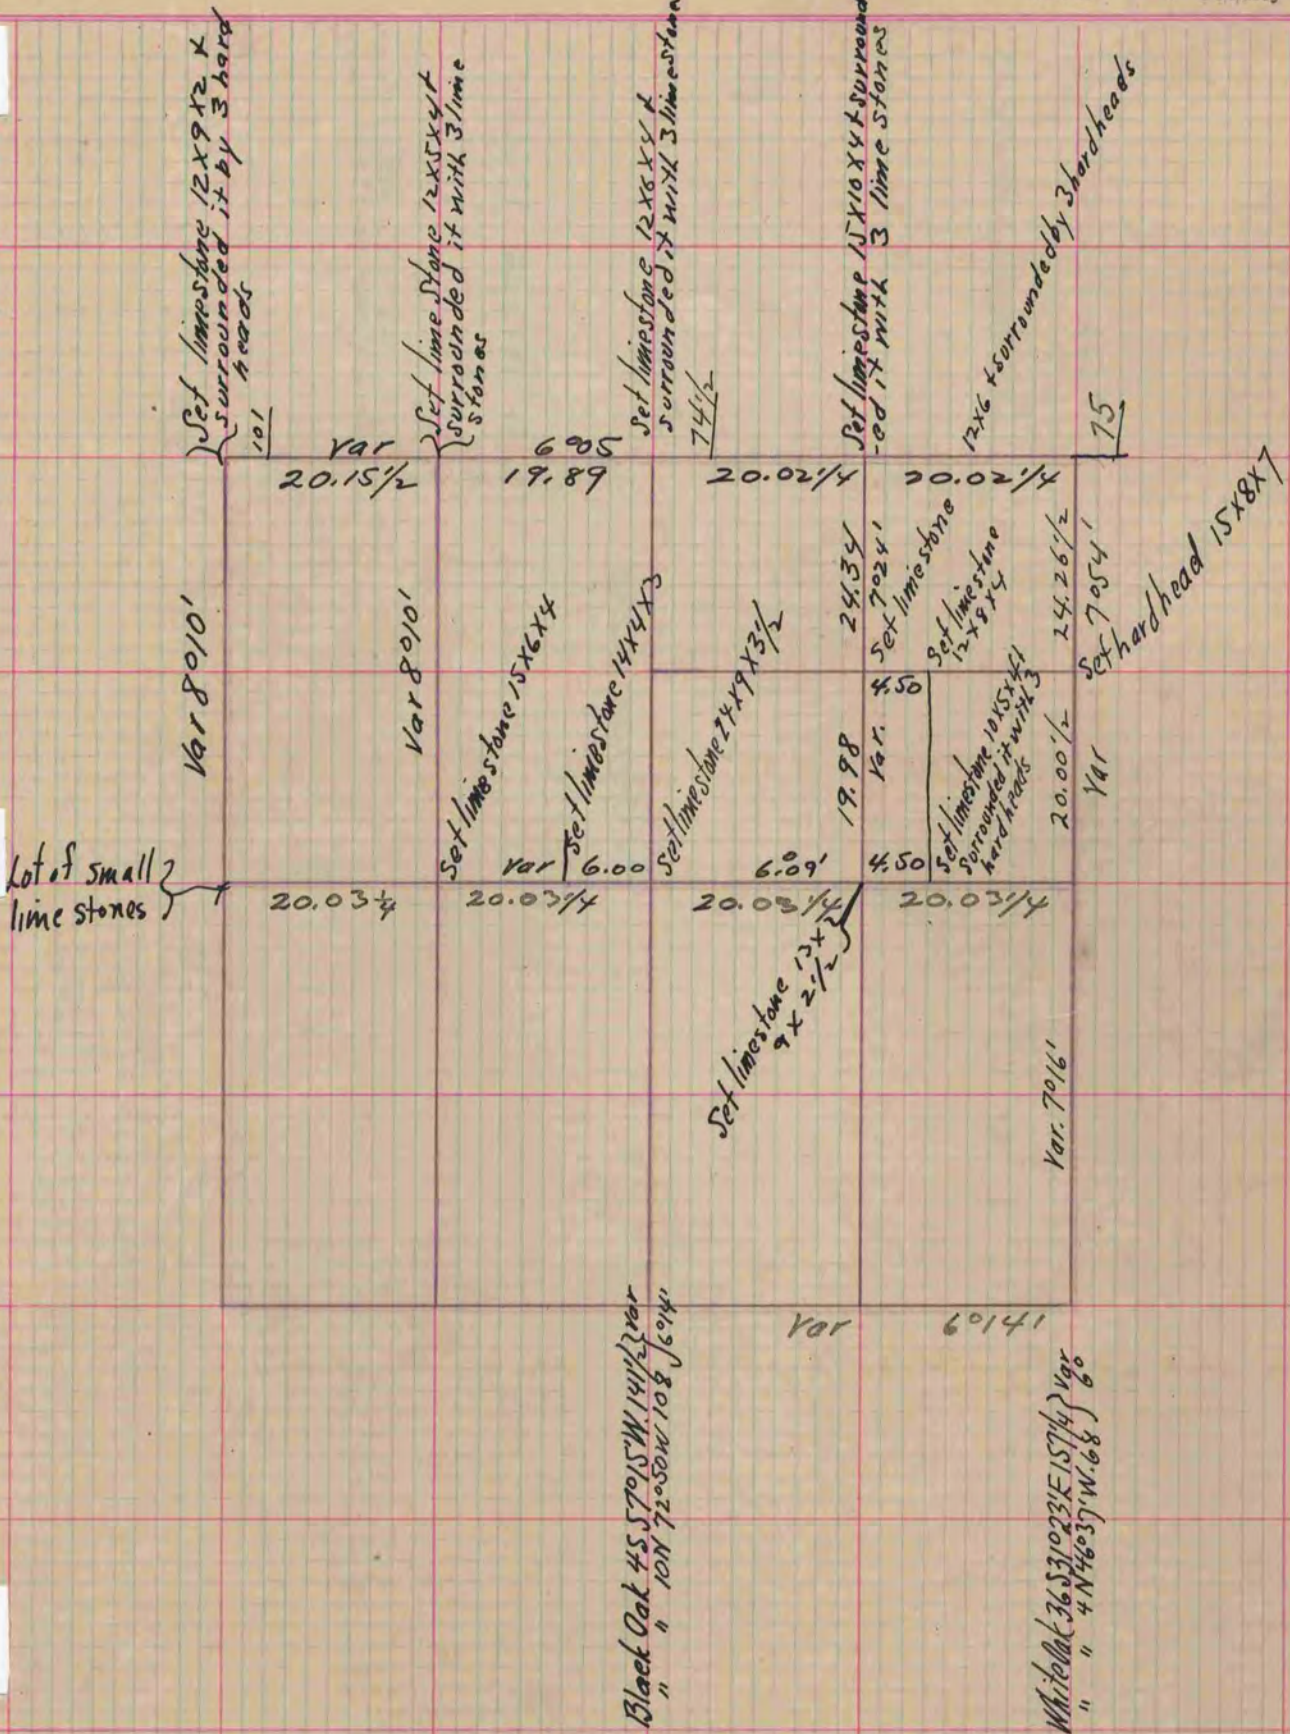

Copied from Page 160 Vol. 1. Original County Surveyors Record