


MICROFILMED PLAT AND RECORD

Of a Survey on Section 17 T 3 R 11 E. of the 4 P. M. in Centre Township
Rock County, Wisconsin, made June the 12th 1863

COUNTY BUILDING
CITY OF JANESVILLE

I hereby certify that the following is a correct record of said survey as made by me.

(Signed) S. D. Locke
R. H. B. County Surveyor.

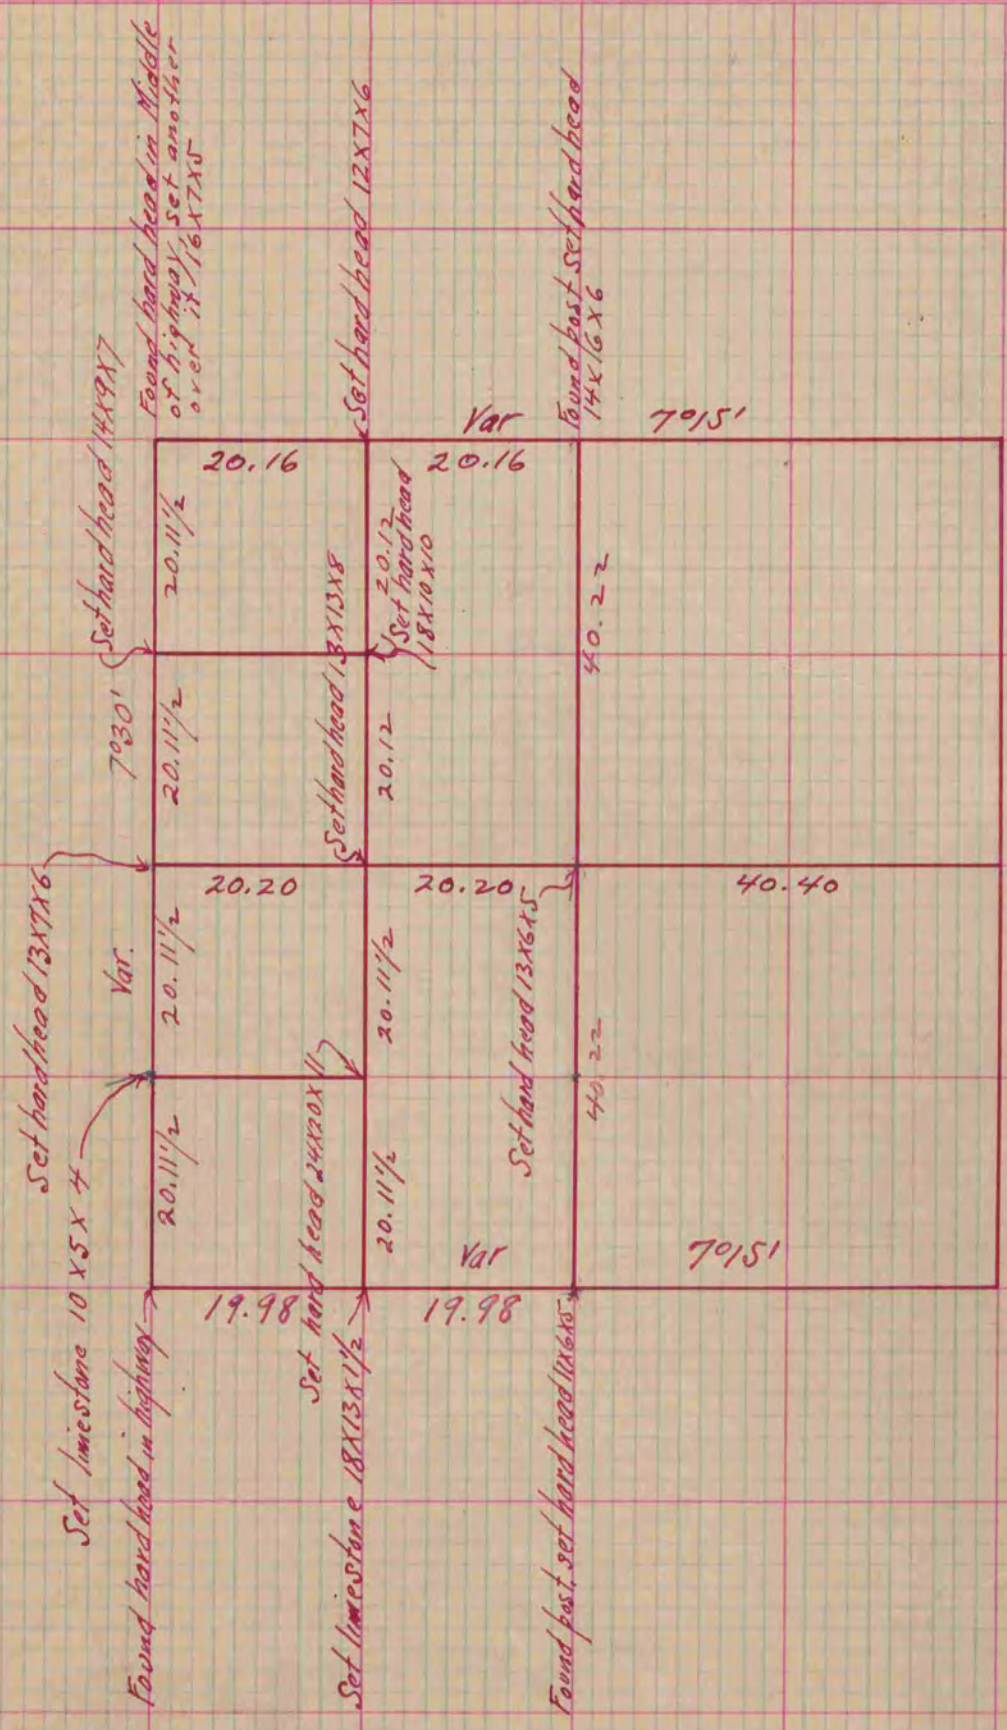

Copied from Upper Part of Page 191 Original Vol. One County Surveyors Record