

# MICROFILMED PLAT AND RECORD


121  
V-1

COUNTY BUILDING  
CITY OF JANESVILLE

Of a Survey on Section 30 T 1 R 13 E. of the 4 P. M. in Turtle Township  
Rock County, Wisconsin, made October the 1st 1859

I hereby certify that the following is a correct record of said survey as made by me.

(Signed) E. F. Hobart Deputy  
R. H. B. County Surveyor.

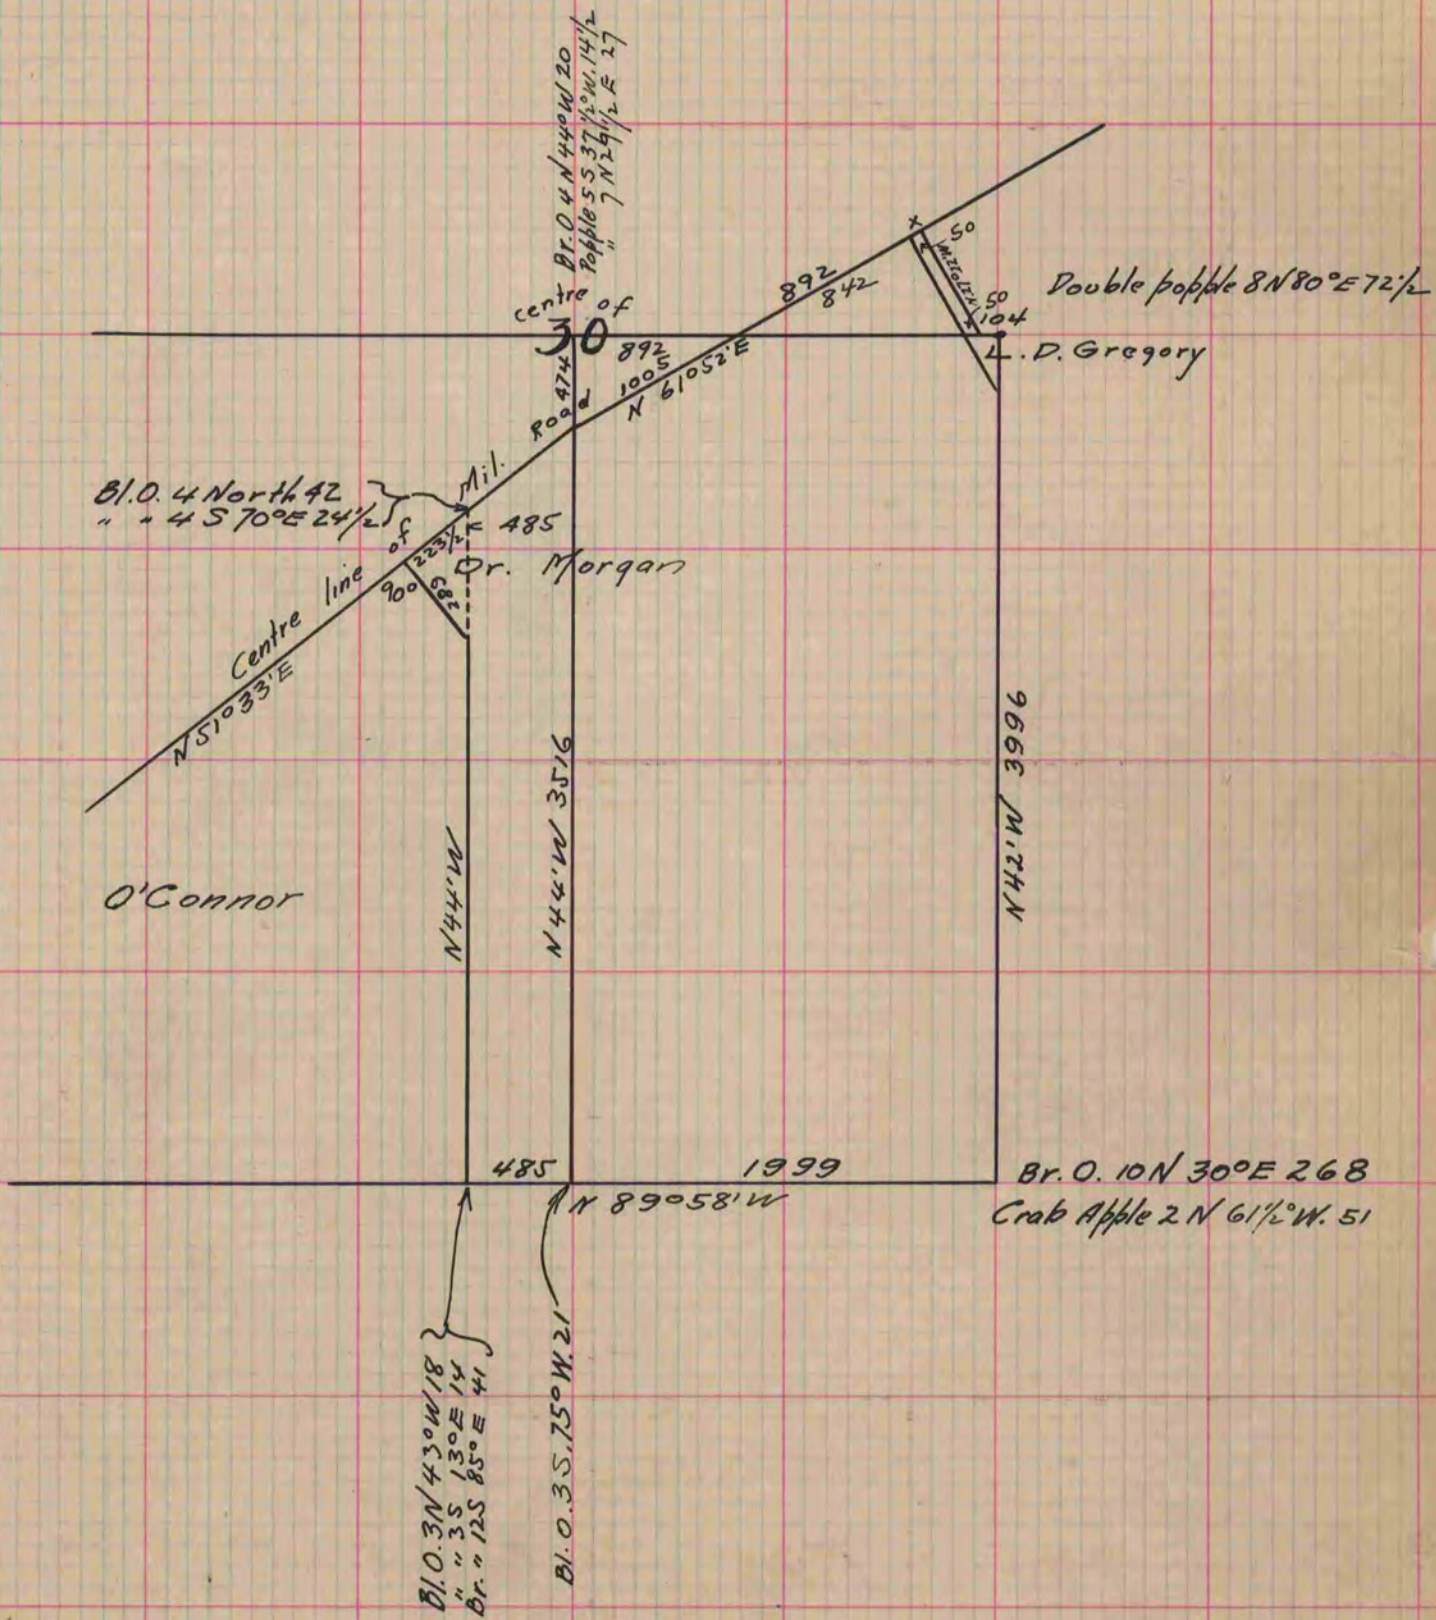

Copied from Page 130 Vol. One Original County Surveyors Record