

120
✓- MICROFILMED


PLAT AND RECORD

Of a Survey on Sections 23 + 26 T 1 R 12 E. of the 4 P. M. in Beloit Township
Rock County, Wisconsin, made June the 27th 1857

I hereby certify that the following is a correct record of said survey as made by me.

COUNTY BUILDING
CITY OF JANESVILLE

(Signed) E. F. Hobart Deputy
R. H. B. County Surveyor.

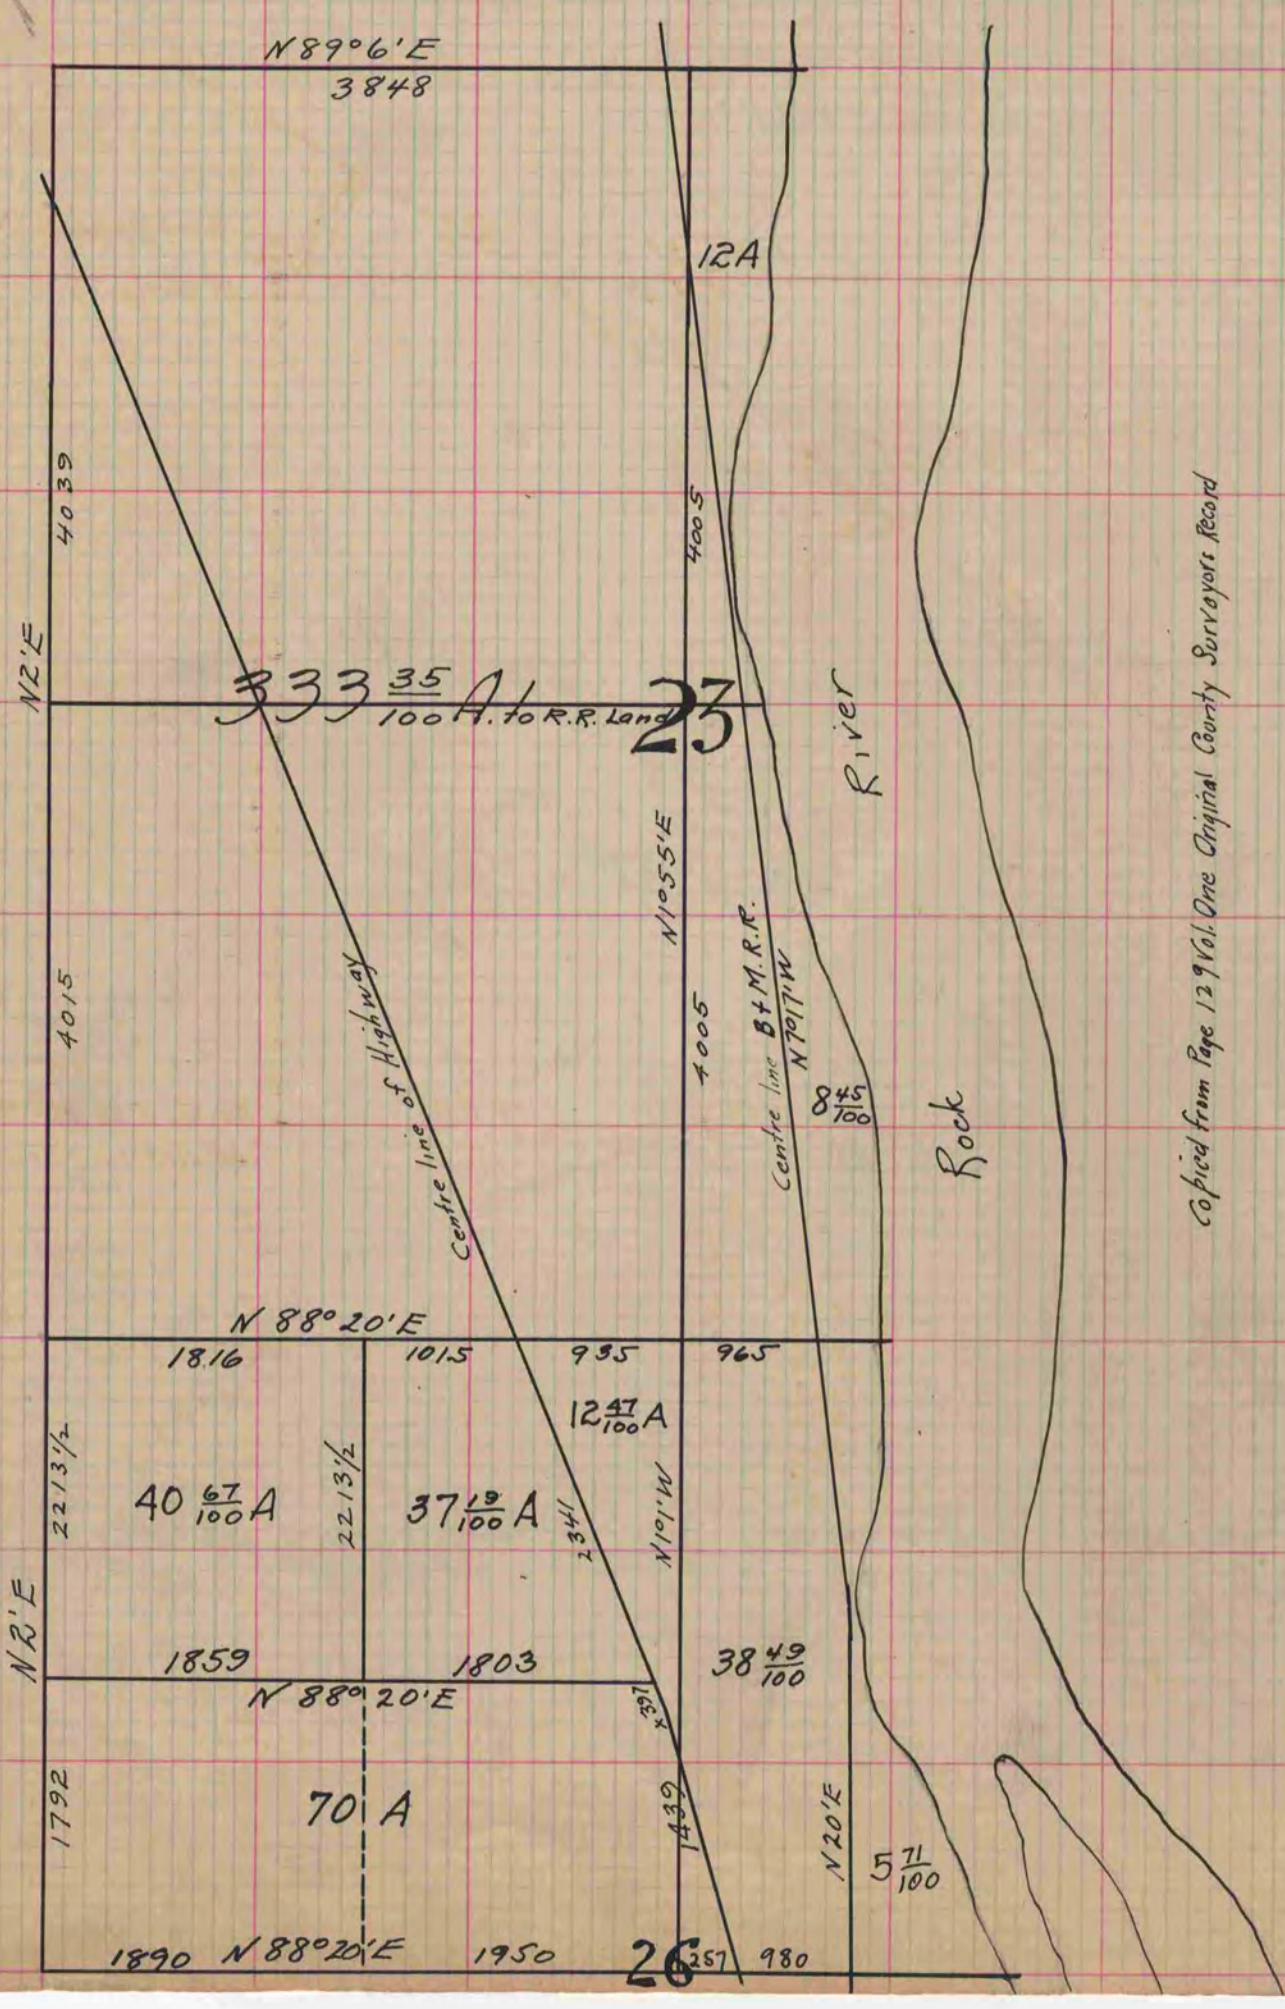

Copied from Page 129 Vol. One Original County Surveyors Record