

PLAT AND RECORD

MICROFILMED


COUNTY BUILDING
CITY OF JANESVILLE

Of a Survey on Section 36 T 2 R 12 E. of the 4 P. M. in Rock Township

Rock County, Wisconsin, made May the 29th & 30th 1873

I hereby certify that the following is a correct record of said survey as made by me.

(Signed) R. K. Lee of Deputy
R.A.B. County Surveyor.

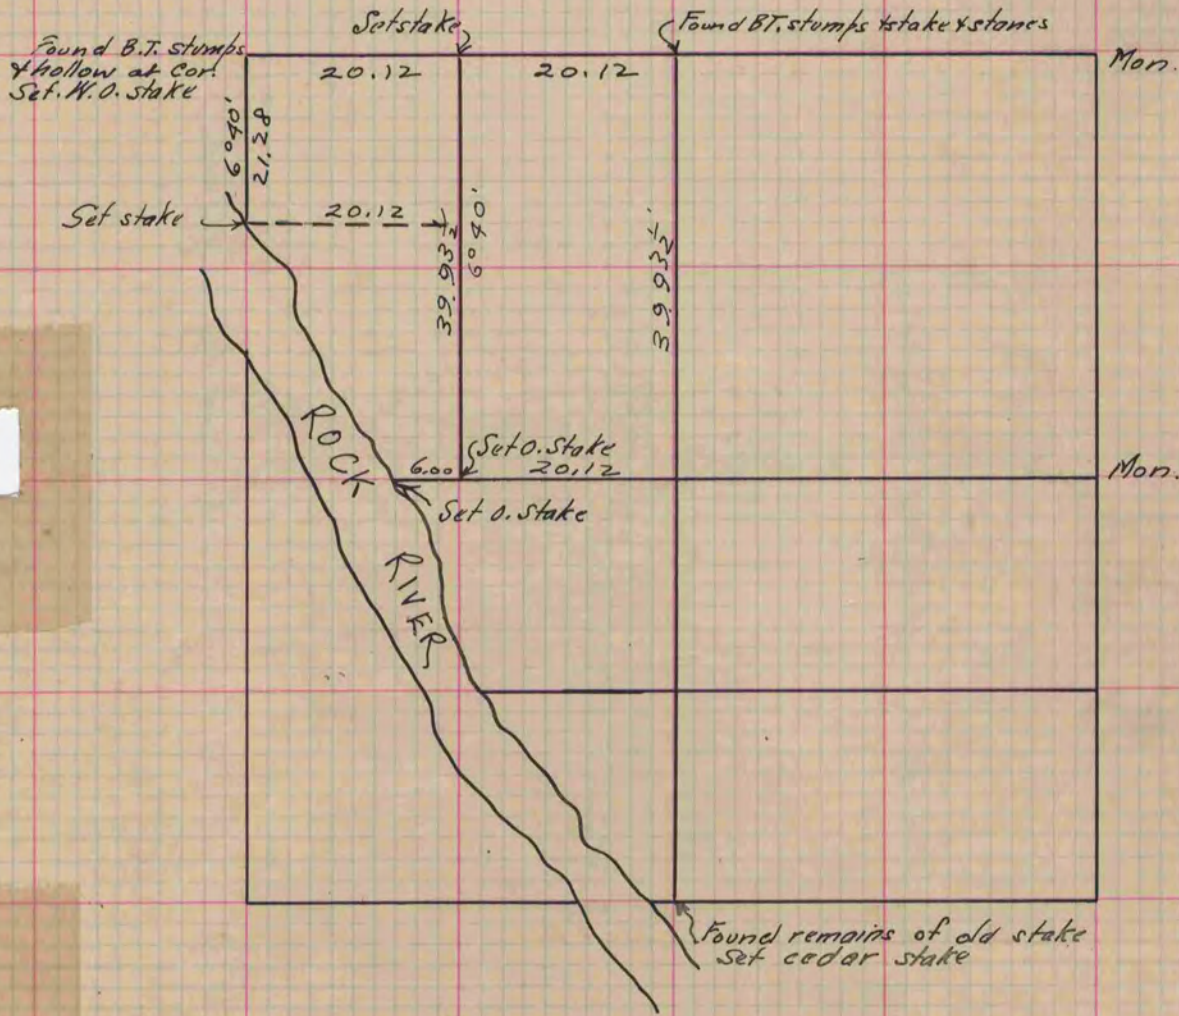

Copied from Page 61 Vol. 2 Original County Surveyors Record