

MICROFILMED

PLAT AND RECORD


111
V-2

COUNTY RECORDING
CITY OF JANESVILLE

Of a Survey on Section 16 T 2 R 11 E. of the 4 P. M. in Plymouth Township
Rock County, Wisconsin, made October the 20th 1873

I hereby certify that the following is a correct record of said survey as made by me.

(Signed) Edward Ruger
R. H. S. County Surveyor.

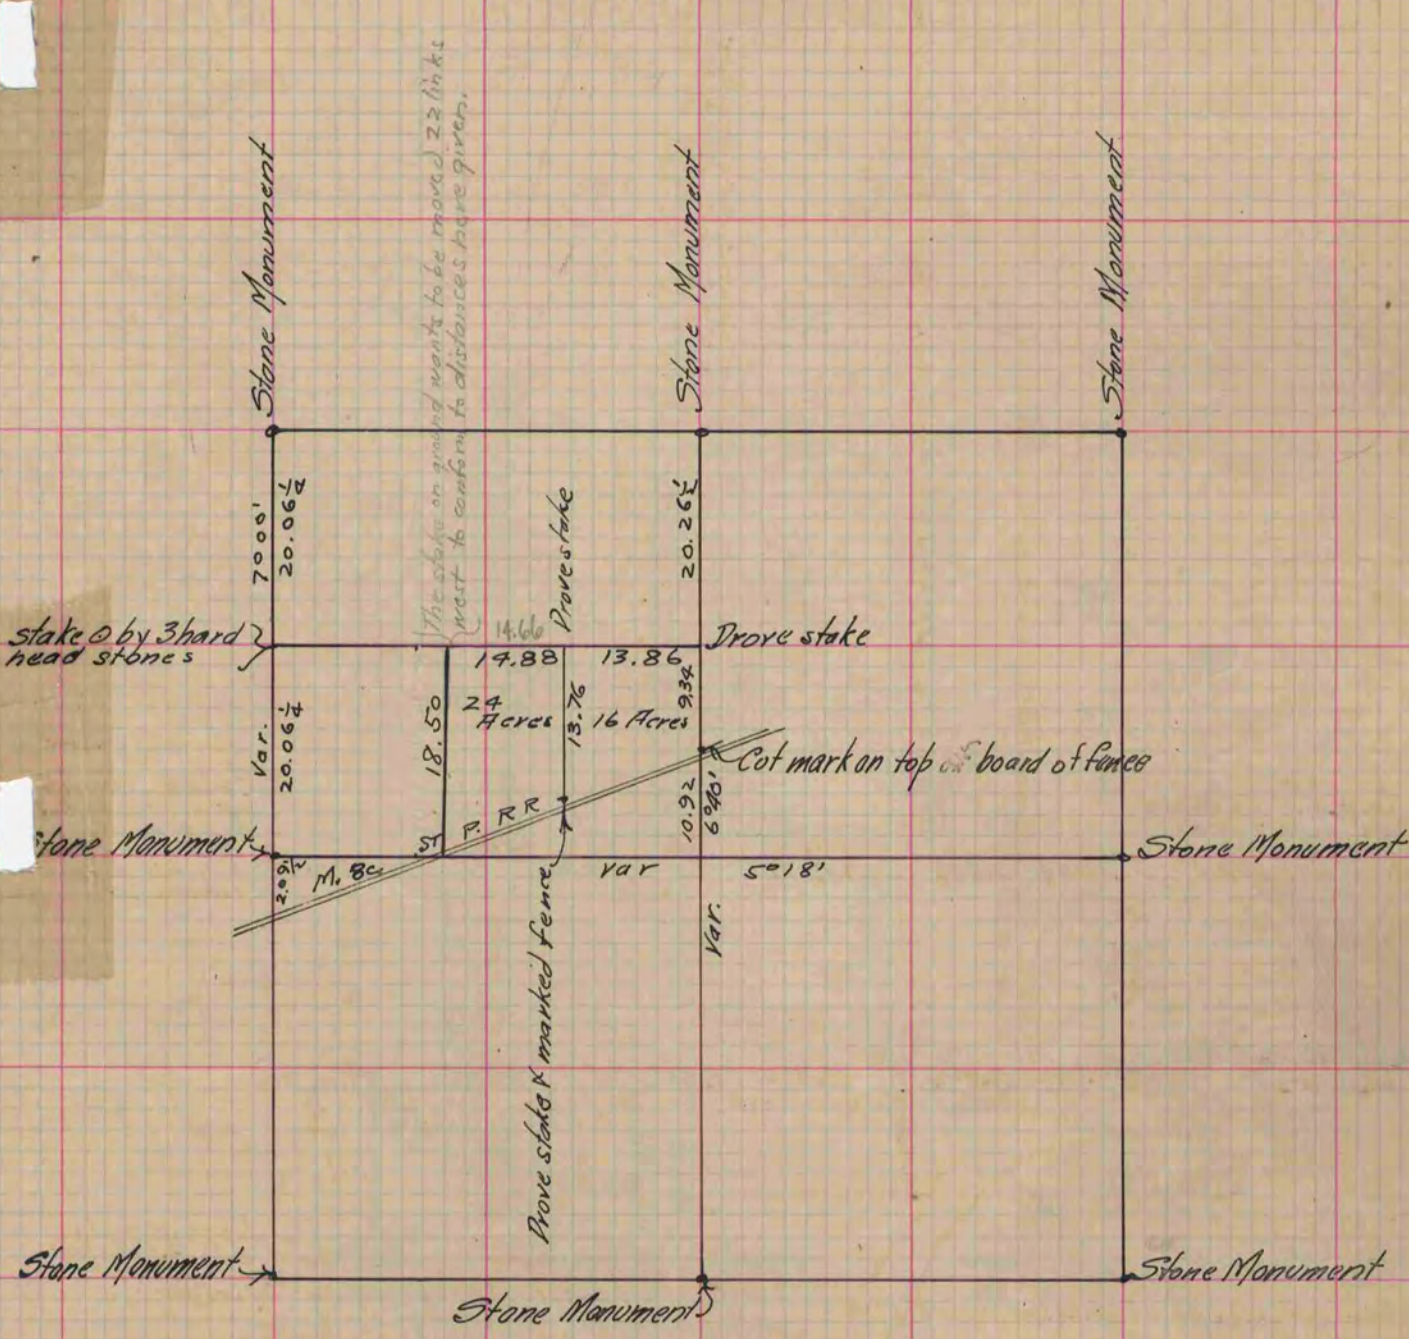

Copied from Page 69 Vol. 2 Original County Surveyors Record