
U.S. PUBLIC LAND SURVEY MONUMENT RECORD

For Public Land Survey Corners in the T. 4 N., R. 14 E. LIMA THE

CORNER CODE INDEX

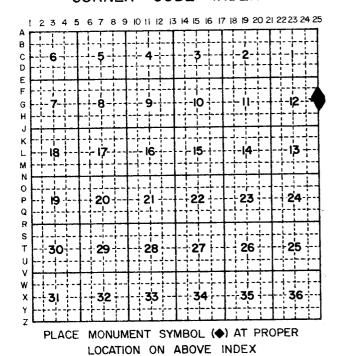


IF AVAILABLE STATE PLANE COORDINATES

North (Y)301 268.28 Eleve. (Z) 274


East (X) 2,328,087,38 Zone South


Hor. Datum _____ Vert. Datum

For Miscellaneous Corners within Sec.

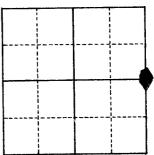


- Above code numbers are positioned Meander, Claim, or Fractional corners of the section.
- 2. Township corner code numbers shall be applied to the corners of above typical section.

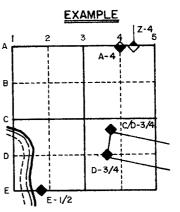

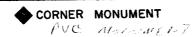

O WITNESS MONUMENT

SET GARSONITE POST WITH SIGN

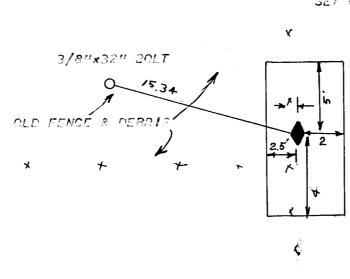


HOLE 1.5' DEER

MICROFILMED

SHOW A PLAN VIEW DRAWING DEPICTING THE CORNER MONUMENT AND SURROUNDING PHYSICAL FEATURES, INCLUDING THE EXCAVATION AREA AND DEPTH. THE CORNER MONUMENT SHALL HAVE THE FOLLOWING CHARACTERISTICS: I) HAVE AT LEAST TWO PREDETERMINED BREAK-OFF POINTS. 2) IF BROKEN, LEAVE A PERMANENTLY MAGNETIZED REMNANT AT THE ORIGINAL POINT. 3) MUST BE EXTENDABLE. 4) THE CAP IS INSCRIBED: ROCK COUNTY SURVEY MONUMENT - PENALTY FOR DISTURBING MARKER. 5) OR AN EXISTING CUT LIMESTONE. AN IRON PIPE I 2" x 4'0" (MINIMUM) WITH AT LEAST 4 DURABLE WITNESS MONUMENTS MAY BE USED IN AREAS WHERE GROUND WATER IS WITHIN I.0' OF THE SURFACE. IF THE CORNER IS OCCUPIED BY AN IMPROVEMENT (MANHOLE, BURIED CABLE, ETC.), ANY DURABLE, DISTINCT MONUMENT MAY BE USED AND REFERENCED WITH AT LEAST 4 DURABLE WITNESS MONUMENTS.

	and whether the monument was found or set.
OUS & FOUND NOTH	ING. SET TVC MCNUMENT.
Describe any ma	terial discrepancy between the location of the
corner as resto	red or re-established and the location of that
corner as previ	ously restored or re-established.
Was the corner evidence location	restored through acceptance of an obliterated on or a found perpetuated location.
evidence locati	on or a found perpetuated location.
evidence location of the contract of the contr	on or a found perpetuated location. TED EVIDENCE. SET THE CORNER ON LINE WITH THE GENTER
evidence location of SEC 12 AMO THE	on or a found perpetuated location. TED EVIDENCE. SET THE CORNER ON LINE WITH THE GENTER S1/18th CORNER OF THE NE1/4 OF SEC 12 AT BINGLE FROM
evidence location of SEC 12 AMO THE	on or a found perpetuated location. TED EVIDENCE. SET THE CORNER ON LINE WITH THE GENTER
evidence location of SEC 12 AMO THE	on or a found perpetuated location. TED EVIDENCE. SET THE CORNER ON LINE WITH THE GENTER S1/18th CORNER OF THE NE1/4 OF SEC 12 AT BINGLE FROM
evidence location of SEC 12 AMO THE OISTANCE. THIS I	on or a found perpetuated location. TED EVIDENCE. SET THE CORNER ON LINE WITH THE GENTER SI/18th CORNER OF THE NEI/4 OF SEC 12 AT SINGLE FROM SIN HARMONY WITH OCCUPATION. re-established through lost corner proportionate
evidence location of SEC 12 AMO THE OIST MCE. THIS I was the corner methods? If so	on or a found perpetuated location. TED EVIDENCE. SET THE CORNER ON LINE WITH THE GENTER SIMILARMONY WITH OCCUPATION. re-established through lost corner proportionate, show the method, including directions and
evidence location of the corner is methods? If so distances to other corner is distances.	on or a found perpetuated location. TED EVIDENCE. SET THE CORNER ON LINE WITH THE GENTER SI/18th CORNER OF THE NEI/4 OF SEC 12 AT SINGLE FROM SIN HARMONY WITH OCCUPATION. re-established through lost corner proportionate
evidence location of the corner is methods? If so distances to other corner is distances.	on or a found perpetuated location. TED EVIDENCE. SET THE CORNER ON LINE WITH THE GENTER SIMILARMONY WITH COCUPATION. re-established through lost corner proportionate, show the method, including directions and her public land survey corners used as evidence
, hereby certify—that the corner points as identified by the corner code index were, in a field survey on Sep 1 1982—, established, re-established, monumented, re-monumented, recovered or restored as expressed below and in conformance with the regulations and rules as required in the current manual of survey instructions of the United States Department of Interior, Bureau of Land Management.

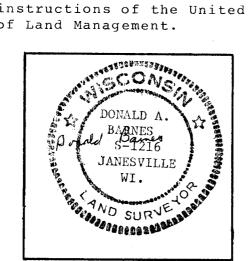

COUNTY SURVEYOR FILING DATA		
Date of Computer Entry		
Date Received		
Date Microfilmed 10/15/1984		
Treasurer's Receipt No.		
Number of Included Sheets		

Affix your land surveyor seal. 625