
## U.S. PUBLIC LAND SURVEY MONUMENT RECORD

For Public Land Survey Corners in \_\_TWP. T. 4\_\_\_N., R. \_

For Miscellaneous Corners within Sec. \_\_\_\_\_, T. \_\_\_\_N. , R. \_\_\_\_E.

## CORNER CODE INDEX

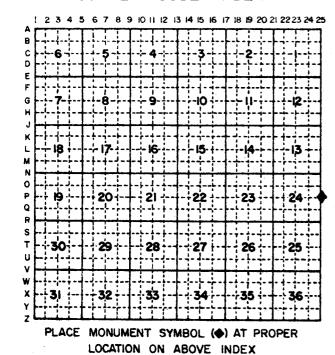

Above code numbers are positioned Meander, Claim, or Fractional corners of the section.

Township corner code numbers shall be applied to the corners of above typical section.

## EXAMPLE !C/D-3/ D-3/4

IF AVAILABLE STATE PLANE COORDINATES

North (Y)290697.08

Eleve. (Z)

East (X)2328018.85

Zone SOUTH


(a.)

Vert. Datum +0°50'23" SCALE FACTOR 0,9999888267

> CORNER MONUMENT SET CAST IRON MON

O WITNESS MONUMENT 3/8 x 28" IRON BOLT

LAT#TUDE 42°47'27.5994" LONGITUDE 88º46 140. 707"

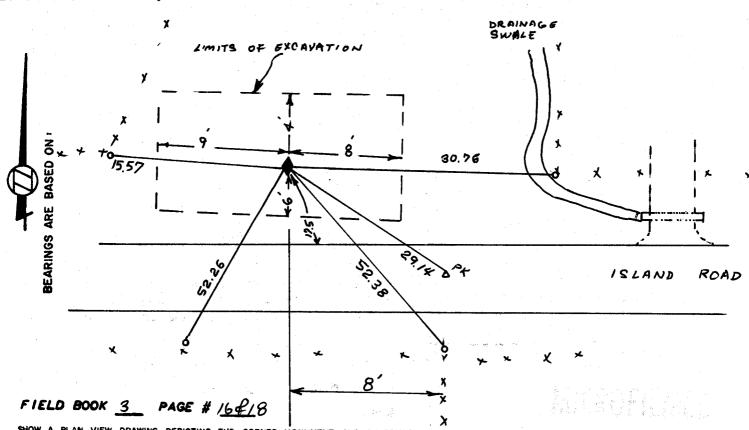

SHOW A PLAN VIEW DRAWING DEPICTING THE CORNER MONUMENT AND SURROUNDING PHYSICAL FEATURES, INCLUDING THE EXCAVATION AREA AND DEPTH. THE CORNER MONUMENT SHALL HAVE THE FOLLOWING CHARACTERISTICS: 1) HAVE AT LEAST TWO PREDETERMINED BREAK-OFF POINTS. 2) IF BROKEN, LEAVE A PERMANENTLY MAGNETIZED REMNANT AT THE ORIGINAL POINT. 3) MUST BE EXTENDABLE. 4) THE CAP IS INSCRIBED : ROCK COUNTY SURVEY MONUMENT - PENALTY FOR DISTURBING MARKER. 5) OR AN EXISTING CUT LIMESTONE. AN IRON PIPE I'N 4'0" (MINIMUM) MAY BE USED IN AREAS WHERE GROUND WATER IS WITHIN ONE FOOT OF THE SURFACE. IF THE CORNER IS OCCUPIED BY AN IMPROVEMENT (MANHOLE, BURIED CABLE, ETC.) ANY DURABLE, DISTINCT MONUMENT MAY BE USED. CORNERS SHALL BE REFERENCED WITH AT LEAST 4 DURABLE WITNESS MONUMENTS. WITNESS MONUMENTS SHALL BE MADE OF CONCRETE, NATURAL STONE, IRON OR OTHER EQUALLY DURABLE MATERIAL, EXCEPT WOOD. DESCRIBE THE CORNER AND THE WITNESS MONUMENTS.

CORNER CODE: P-25

	Describe any reco	ord evidence, mo					
DU	any other materia	al evidence you	nument evidence considered, and	, occupational whether the m	evidence, te onument was≕	estimonial evide Found or placed.	ence or
N	UG 4' DEEP AND OTES. SET CAST		The second secon	and the second of the second o	10 1 1w		. FIEL
	<b>32</b> , <b>3</b> , .3,					Marine Company	
		•					
		, and the second of the second					in the second
				e vi		e de la companya del companya de la companya de la companya del companya de la co	
				•	· · · · · · · · · · · · · · · · · · ·		
							(3) a
2.)	Was the corner refound perpetuate	restored through ed_location?	acceptance of (	(i) an oblitera	ted evidence	iocation, or,	(2) 6
	NO ···						
				en e	en Toga <del>lia</del>	to the second of	
	by distance and above. Show the and (1) the corn	nd the location of direction. Show the distances between as restored of the drawing in the drawi	v the discrepand een the corner a or reestablished	cy on the plan	view drawing estored or r	under ( <b>c</b> ), eestablished	*
	NA			sint in the	en de la companya de La companya de la co		*
			jii ka magaa	er gewongse sellereke offere bry in term on egen om of och or o	a september 1990 of the	Section of the sectio	214 1 1 1 1 1 1 1 1 1 1 1 1 1 1 1 1 1 1
		success of the second s				and the second s	
	The state of the s				. *		
					. \$2.00		
	en e						
	<b>t</b>		e de la companya de l		The second second second	ing and the second of the seco	
				150			
e.) ू	Was the corner	reestablished th	hrough lost con	ner proportions	ite methods?	If so, show th	e
- 3	method, includi	reestablished thing the directioned for proportion	ns and distance	s to other publ	ic land surv	If so, show the	ie Las
- 3	method, includi	ing the direction	ns and distance ning in determin	s to other publining the corner	ic land surv r location,	If so, show the corners used	e as
- 3	method, includi	ing the direction	ns and distance ning in determin	s to other publicing the corner	ic land surv	If so, show th rey corners used	ie Las
- 3	method, includi	ing the direction	ns and distance ning in determine 049 79	s to other publishing the corner	ic land surv r location,	lf so, show th rey corners used	ie Las
- 3	method, includi	ing the direction	ns and distance ning in determine 049 79	s to other publications of the corner of the	ic land surv	ey corners used	e as
- 3	method, includi evidence or use YES	ing the direction ed for proportion	ns and distance ning in determine 0492 9/80	s to other publications of the corner of the	ic land surv r location,	ey corners used	e as
- 3	method, includi evidence or use YES	ing the direction	ns and distance ring in determine 0492 0180	s to other published the corner of the corne	ic land surv	ey corners used	e as
- 3	method, includi evidence or use YES	ing the direction ed for proportion	ns and distance ning in determine 0492 9/80	s to other published the corner of the corne	ic land surv	ey corners used	e as
- 3	method, includi evidence or use YES	ing the direction ed for proportion	ns and distance ring in determing on determing 0497 0180 0497 0797 0797	s to other public of 136 "E N1 ** 06 ** 136 "E N1 ** 06 ** 0	ic land surv	ey corners used	e as
- 3	method, including evidence or use YES  BEARING ON LOCA	ing the direction ed for proportion	ns and distance ring in determing in determing 28/00 0492 9/80 08/18 58/	s to other public orner of the corner of the	ic land surve location.  OR SEC 24  COR SEC 24	ey corners used	l as
- 3	method, including evidence or use YES  BEARING ON LOCA  I, Duran	ing the direction of for proportion of the distance of the dis	ns and distance ning in determing on determing 0,492 0,180 0,80 0,80 0,90 0,80 0,80 0,80 0,80 0,	s to other publisher corner  s to other publisher publis	ic land survivor location.  OR SEC 24  COR SEC 24	ey corners used	ints
- 3	BEARING ON LOCAL AS idential MAY23 198	GS & DISTANCE.  AL DATUM  Bannes  ified by the	ns and distance ring in determing in determing of the determination of t	s to other publisher stablisher or the corner of the corne	COR SEC 24  COR SEC 24  that thee, in a f.	e corner po: ield survey nted, re-mor	ints on
	BEARING ON LOC.  I, Down as identified in the second secon	GS & DISTANCE.  AL DATUM  Bannes  ified by the  3, estable or restored	ns and distance ring in determing in determing of the determination of t	s to other publisher in the corner of the co	COR SEC 24  COR SEC 24  that the e, in a f. d. monumer	e corner po: ield survey nted, re-mor	ints on numen
	BEARING ON LOC  I, Denne as identi MAY23 198 recovered regulatio instructi	GS & DISTANCE AL DATUM  If ied by the  ons and rules ions of the i	s and distance ring in determing in determing of the determing of the determine of the dete	s to other public publi	COR SEC 24  COR SEC 24  that the e, in a f.d., monumer and in consurrent magnitudes.	e corners used  e corner po: ield survey nted, re-mon	ints on numen th the
	BEARING ON LOC  I, Denne as identi MAY23 198 recovered regulatio instructi	GS & DISTANCE.  AL DATUM  Ified by the  ified by treation  one and rules	s and distance ring in determing in determing of the determing of the determine of the dete	s to other public publi	COR SEC 24  COR SEC 24  that the e, in a f.d., monumer and in consurrent magnitudes.	e corners used  c corner po: ield survey nted, re-mon	ints on numen th the
	BEARING ON LOC  I, Denne as identi MAY23 198 recovered regulatio instructi	GS & DISTANCE AL DATUM  If ied by the  ons and rules ions of the i	s and distance ring in determing in determing of the determing of the determine of the dete	s to other public publi	COR SEC 24  COR SEC 24  COR SEC 24  that the e, in a f. d. monumer and in consumption of Interest and the consumption of Interest and	e corner por ield survey nted, re-mor formance wit nual of survey	ints on numen th the
	BEARING ON LOC  I, Denne as identi MAY23 198 recovered regulatio instructi	GS & DISTANCE AL DATUM  If ied by the  ons and rules ions of the i	s and distance ring in determing in determing of the determing of the determine of the dete	s to other publisher in the corner of the co	COR SEC 24  COR SEC 24  COR SEC 24  that thee, in a find, monument maint of Interpretation	e corner por ield survey nted, re-mor formance wit nual of survey	ints on numen th the
	BEARING ON LOC  I, Denne as identi MAY23 198 recovered regulatio instructi	GS & DISTANCE AL DATUM  If ied by the  ons and rules ions of the i	s and distance ring in determing in determine to the state of the stat	s to other publisher in the corner of the co	COR SEC 24  COR SEC 24  COR SEC 24  that thee, in a find, monument maint of Interpretation	e corner por ield survey nted, re-mor formance wit nual of survey	ints on numen th the
	BEARING ON LOC  I, Denne as identi MAY23 198 recovered regulatio instructi	GS & DISTANCE AL DATUM  If ied by the  ons and rules ions of the i	s and distance ring in determing in determing of the determing of the determine of the dete	SE to other publisher ing the corner to other publisher corner to the co	COR SEC 24  COR SEC 24  COR SEC 24  that the e, in a fid, monumer and in consumption of Interest and the consumption of Interest and Interest an	e corner por ield survey nted, re-mor formance wit nual of survey	ints on numen th the
(a) 101 (b) (c) (c) (c) (c) (c) (c) (c) (c) (c) (c	BEARING ON LOC  I, Denne as identi MAY23 198 recovered regulatio instructi	GS & DISTANCE AL DATUM  If ied by the  ons and rules ions of the i	s and distance ring in determing in determing of the determing of the determine of the dete	s to other publisher in the corner of Comput	COR SEC 24  COR SEC 24  COR SEC 24  that the e, in a f. d. monumer and in consurrent main a	e corner por ield survey nted, re-mor formance wit nual of survey	ints on numen th the

AFFIX YOUR LAND SURVEYOR SEAL. P25