
U.S. PUBLIC LAND SURVEY MONUMENT RECORD

For Public Land Survey Corners in:

WI ADMINISTRATIVE CODE A-E 7.08 REQUIREMENT

T.4N., R. 14E

CORNER CODE INDEX

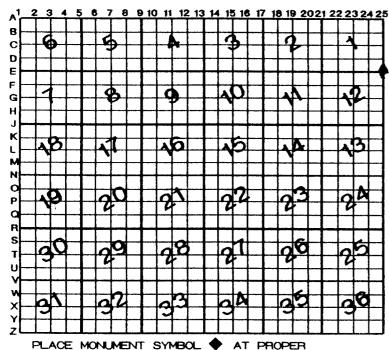

UMA	!	TWF
ROCK	COUNTY	WI

IF AVAILABLE ROCK COUNTY COORDINATES PERFERRED

North _____ Elev. ____

East _____

Hor. Datum ____ Vert. Datum ____

LATITUDE ____ ELLIPS. HT.

LONGITUTE ____ TRAVERSE (X) ___

BASED ON THE FOLLOWING CONTROL:

•	CORNER	MONUMENT

LOCATION ON ABOVE INDEX

O WITNESS MONUMENT

BEARINGS ARE BASED ON:

(a)

		•	
		· /	7
FIELD	BOOKPAGE #	SHEET OF	
SHOW	A PLAN VIEW DRAWING DEPICTING THE CORNER MONUMENT	AND SURROUNDING	

PHYSICAL FEATURES, INCLUDING THE EXCAVATION AREA AND DEPTH.
PLANNING & ZONING COMMITTEE ADOPTED THE ABOVE FORM ON 12/2/1982

CORNER CODE \mathcal{E}^{-25}

1.1533

(B)Describe any record evidence, monument evidence, occupational evidence, testimonial evidence or any other material evidence you considered, and whether the monument was found or placed.

1982 BARNES VOL 6 PG 245 FOUND BRASS CAP IN PAVEMENT. SET 3/8X32 BOLTS AS REFERENCE MONUMENTS. REFERENCE VOL 3, PG 456. FIELD BOOK; LIMA, PAGE 46.

FOUND WALWORTH COUNTY DISK IN CONCRETE 0.3' DEEP. DID NOT SEARCH FOR REFERENCE BOLT MONUMENTS. FOUND DISK IN CONCRETE WITH SURVEY SIGN FOR REFERENCE MONUMENTS. MONUMENT MAY BE DISTURBED.BY POROCONSTRUCTION

C) Was the corner restored through acceptance of (1) an obliterated evidence location, or, (2) a found perpetuated location?

ACCEPTED FOUND PERPETUATED LOCATION.


- D) Describe any material discrepancy between the location of the corner as restored or reestablished and the location of that corner as previously restored or reestablished by distance and direction. Show the discrepancy on the plan view drawing under (a), above. Show the distances between the corner as previously restored or reestablished and (1) the corner as restored or reestablished, and (2) to at least 4 of the witness monuments shown on the drawing in (a), above.
- (E) Was the corner reestablished through lost corner proportionate methods? If so, show the method, including the directions and distances to other public land survey corners used as evidence or used for proportioning the corner location.

I, Donald Barnes, hereby certify that the corner location as identified by the corner code index was determined by me under my direction and control and that this U.S. Public Land Survey Monument Record is correct and complete to the best of my knowledge and belief.

June 4 1999

Number of included sheets 1

emboss

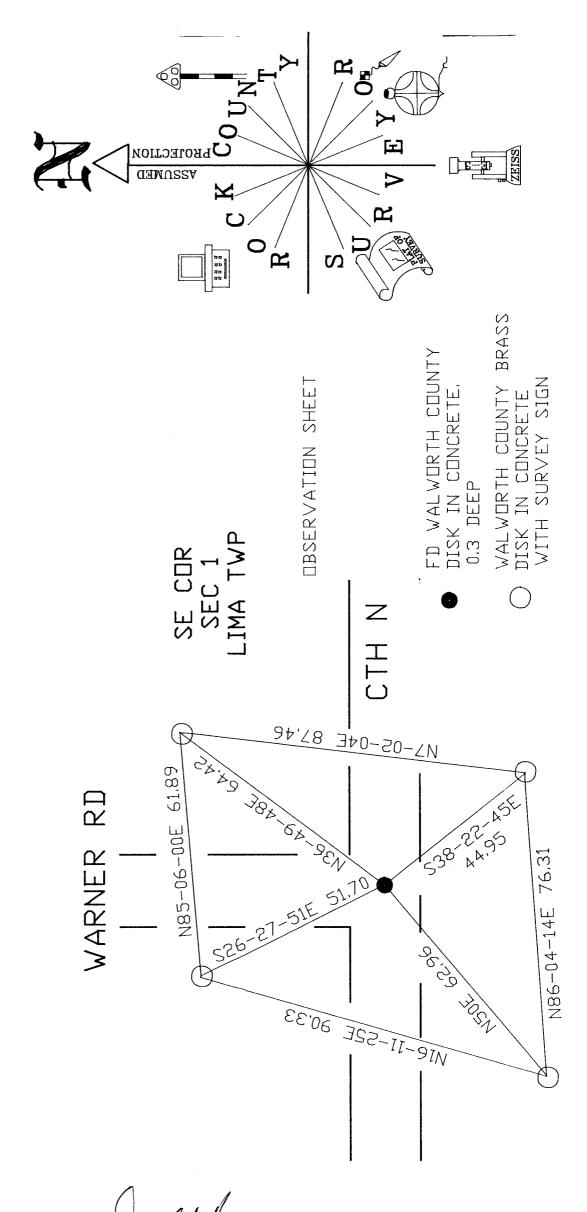

EMBOSSED SEAL
May 28, 1999

E - 25