
U.S. PUBLIC LAND SURVEY MONUMENT RECORD

For Public Land Survey Corners in the

11. 4 N., R. 14 E.

CORNER CODE INDEX

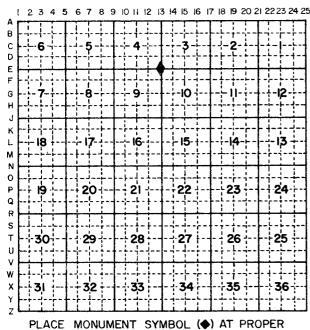


LOCATION ON ABOVE INDEX

IF AVAILABLE STATE PLANE COORDINATES


North (Y)304282.90 Eleve. (Z)

East (X)2,312,096.63 Zone South

Hor. Datum _____ Vert. Datum

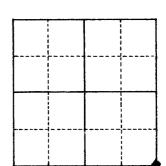


- Above code numbers are positioned Meander, Claim, or Fractional corners of the section.
- Township corner code numbers shall be applied to the corners of above typical section.

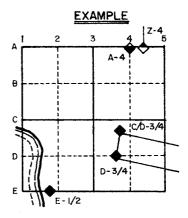

CORNER MONUMENT

O WITNESS MONUMENT



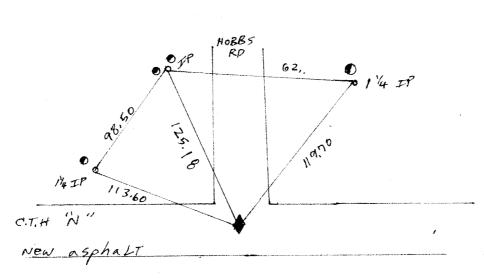

SET POLYSTYRENE MON

MICROFILMED

SHOW A PLAN VIEW DRAWING DEPICTING THE CORNER MONUMENT AND SURROUNDING PHYSICAL FEATURES, INCLUDING THE EXCAVATION AREA AND DEPTH. THE CORNER MONUMENT SHALL HAVE THE FOLLOWING CHARACTERISTICS: i) HAVE AT LEAST TWO PREDETERMINED BREAK-OFF POINTS. 2) IF BROKEN, LEAVE A PERMANENTLY MAGNETIZED REMNANT AT THE ORIGINAL POINT. 3) MUST BE EXTENDABLE. 4) THE CAP IS INSCRIBED: ROCK COUNTY SURVEY MONUMENT - PENALTY FOR DISTURBING MARKER. 5) OR AN EXISTING CUT LIMESTONE. AN IRON PIPE 1 x 4'0" (MINIMUM) WITH AT LEAST 4 DURABLE WITNESS MONUMENTS MAY BE USED IN AREAS WHERE GROUND WATER IS WITHIN 1.0' OF THE SURFACE. IF THE CORNER IS OCCUPIED BY AN IMPROVEMENT (MANHOLE, BURIED CABLE, ETC.), ANY DURABLE, DISTINCT MONUMENT MAY BE USED AND REFERENCED WITH AT LEAST 4 DURABLE WITNESS MONUMENTS.

E

13

| | SET PRIOR TO ROAD |
|--|--|
| 0.446694 | |
| CONSTRUCTION | |
| | |
| | |
| | |
| | |
| Describe any material discorner as restored or recorner as previously res | screpancy between the location of the established and the location of that tored or re-established |
| - | |
| NONE | |
| | |
| | |
| Was the corner restored to evidence location or a for | through acceptance of an obliterated ound perpetuated location. |
| | |
| Accepted | TIES |
| | |
| | |
| methods? If so, show the | ished through lost corner proportionate method, including directions and colors land survey corners used as evidence |
| or used for proportioning | g in determination of the corner location |
| or used for proportioning | g in determination of the corner location |
| or used for proportioning | |
| I, as identified by the corn | _, hereby certify that the corner pointer code index were, in a field survey o |
| I, as identified by the corn recovered or restored as regulations and rules as | , hereby certify that the corner pointer code index were, in a field survey ded, re-established, monumented, re-montexpressed below and in conformance with required in the current manual of surve |
| I, Junel Barnel I, identified by the corn Toly 1982, establish recovered or restored as regulations and rules as instructions of the Unite | , hereby certify that the corner pointer code index were, in a field survey ded, re-established, monumented, re-montexpressed below and in conformance with required in the current manual of surve |
| I, Junel Barnel I, identified by the corn The covered or restored as regulations and rules as instructions of the Unite | hereby certify that the corner pointer code index were, in a field survey of the condition of the conformance with required in the current manual of survey of the code of the |
| I, Junel Barnel I, identified by the corn Toly 1982, establish recovered or restored as regulations and rules as instructions of the Unite | , hereby certify that the corner pointer code index were, in a field survey ded, re-established, monumented, re-montexpressed below and in conformance with required in the current manual of surved States Department of Interior, Bureau COUNTY SURVEYOR FILING DATA |
| I, Junel Barnel I, identified by the corn Toly 1982, establish recovered or restored as regulations and rules as instructions of the Unite | , hereby certify that the corner pointer code index were, in a field survey of the code index were, in a field survey of the code index were, in a field survey of the conformance with the current manual of survey of the code of the current manual of survey of the code of the current code of the current code of the current code of the code o |
| I, as identified by the corn recovered or restored as regulations and rules as instructions of the Unite of Land Management. | , hereby certify that the corner pointer code index were, in a field survey ded, re-established, monumented, re-money expressed below and in conformance with required in the current manual of surved States Department of Interior, Bureau COUNTY SURVEYOR FILING DATA Date of Computer Entry Date Received |
| I, as identified by the corner of the corner of the united as regulations and rules as instructions of the United of Land Management. | , hereby certify that the corner pointer code index were, in a field survey med, re-established, monumented, re-money expressed below and in conformance with required in the current manual of surved States Department of Interior, Bureau COUNTY SURVEYOR FILING DATA Date of Computer Entry Date Received Date Microfilmed |
| I, as identified by the cornection of the land Management. Donald Rames 1, identified by the cornection of the United Stand Management. Donald A. BARNES S-1216 JANESVILLE | , hereby certify that the corner pointer code index were, in a field survey of the condition of the conformance with the corner pointeressed below and in conformance with required in the current manual of surved States Department of Interior, Bureau COUNTY SURVEYOR FILING DATA Date of Computer Entry Date Received Date Microfilmed 10/15/4844 Treasurer's Receipt No. |
| I, as identified by the cornections of the United Structions of the United Structure Struct | Date of Computer Entry Date Received Date Microfilmed 10/15/1984 |
| I, as identified by the cornection of the land Management. DONALD A. BARNES S-1216 JANESVILLE | nereby certify that the corner point for code index were, in a field survey of the condition of the conformance with the corner point expressed below and in conformance with required in the current manual of survered States Department of Interior, Bureau COUNTY SURVEYOR FILING DATA Date of Computer Entry Date Received Date Microfilmed 10/15/1984 Treasurer's Receipt No. |

AFFIX YOUR LAND SURVEYOR SEAL. E13