U.S. PUBLIC LAND SURVEY MONUMENT RECORD

For Public Land Survey Corners in the LIMA T. 4 N., R. 14 E.

CORNER CODE INDEX

Q

R S

30

29

PLACE MONUMENT SYMBOL (♠) AT PROPER LOCATION ON ABOVE INDEX

28


IF AVAILABLE STATE PLANE COORDINATES

North (Y)283,348.39 Eleve. (Z) 975


East (X)2,298,396.50 Zone <u>South</u>

Hor. Datum _____ Vert. Datum

For Miscellaneous Corners within Sec.

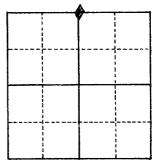


- Above code numbers are positioned Meander, Claim, or Fractional corners of the section.
- Township corner code numbers shall be applied to the corners of above typical section.

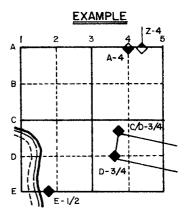

CORNER MONUMENT

26

O WITNESS MONUMENT

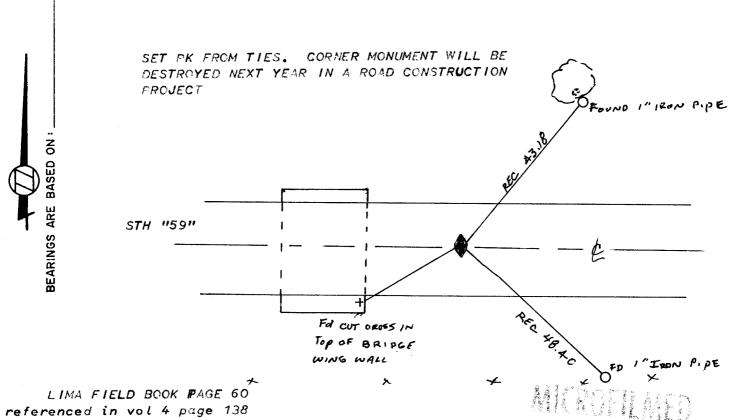

SHOW A PLAN VIEW DRAWING DEPICTING THE CORNER MONUMENT AND SURROUNDING PHYSICAL FEATURES, INCLUDING THE EXCAVATION AREA AND DEPTH. THE CORNER MONUMENT SHALL HAVE THE FOLLOWING CHARACTERISTICS: I) HAVE AT LEAST TWO PREDETERMINED BREAK-OFF POINTS. 2) IF BROKEN, LEAVE A PERMANENTLY MAGNETIZED REMNANT AT THE ORIGINAL POINT. 3) MUST BE EXTENDABLE. 4) THE CAP IS INSCRIBED: ROCK COUNTY SURVEY MONUMENT - PENALTY FOR DISTURBING MARKER. 5) OR AN EXISTING CUT LIMESTONE. AN IRON PIPE I 1/2" x 4'0" (MINIMUM) WITH AT LEAST 4 DURABLE WITNESS MONUMENTS MAY BE USED IN AREAS WHERE GROUND WATER IS WITHIN 1.0' OF THE SURFACE. IF THE CORNER IS OCCUPIED BY AN IMPROVEMENT (MANHOLE, BURIED CABLE, ETC.), ANY DURABLE, DISTINCT MONUMENT MAY BE USED AND REFERENCED WITH AT LEAST 4 DURABLE WITNESS MONUMENTS.

SET PK FROM REFERENCE TIES.	
Describe any material dise	crepancy between the location of the
corner as restored or re-corner as previously resto	established and the location of that ored or re-established.
Was the corner restored the evidence location or a for	nrough acceptance of an obliterated
	ing the obliterated evidence (reference tie
in vol 4 page 138)	
methods? If so, show the distances to other public	shed through lost corner proportionate method, including directions and land survey corners used as evidence in determination of the corner location
methods? If so, show the distances to other public	method, including directions and land survey corners used as evidence
methods? If so, show the distances to other public or used for proportioning	method, including directions and
methods? If so, show the distances to other public or used for proportioning	method, including directions and land survey corners used as evidence
methods? If so, show the distances to other public or used for proportioning	method, including directions and land survey corners used as evidence
methods? If so, show the distances to other public or used for proportioning NO I, as identified by the corner of JUNE 1982, established.	method, including directions and land survey corners used as evidence in determination of the corner location of the corner location the corner location of the corner points are code index were, in a field survey of the corner points of the corner points are code index were, in a field survey of the corner location of the corner points are code index were, in a field survey of the corner location of the corner points are code index were, in a field survey of the corner location
methods? If so, show the distances to other public or used for proportioning NO I, as identified by the corner of JUNE 1982, established recovered or restored as expected as a regulations and rules as regulations.	method, including directions and land survey corners used as evidence in determination of the corner location of the corner location determination of the corner point
methods? If so, show the distances to other public or used for proportioning NO NO as identified by the corner of JUNE 1982 recovered or restored as expectations and rules as reinstructions of the United	method, including directions and land survey corners used as evidence in determination of the corner location determination of the corner points of the corn
methods? If so, show the distances to other public or used for proportioning NO I, as identified by the corner of JUNE 1982, established recovered or restored as executations and rules as reinstructions of the United	method, including directions and land survey corners used as evidence in determination of the corner location determination of the corner location determination of the corner point er code index were, in a field survey of ed, re-established, monumented, re-monumented, respectively and in conformance with required in the current manual of survey of states Department of Interior, Bureau
methods? If so, show the distances to other public or used for proportioning NO I, as identified by the corner of June 1982, established to be second or restored as exceptlations and rules as restructions of the United	method, including directions and land survey corners used as evidence in determination of the corner location determination of the corner location determination of the corner point er code index were, in a field survey of ed, re-established, monumented, re-monumented and in conformance with required in the current manual of survey of States Department of Interior, Bureau COUNTY SURVEYOR FILING DATA
methods? If so, show the distances to other public or used for proportioning NO NO as identified by the corner of JUNE 1982 recovered or restored as expectations and rules as reinstructions of the United	method, including directions and land survey corners used as evidence in determination of the corner location determination of the corner location determination of the corner location determination of the corner point of the c

affix your land surveyor seal. $\sqrt{3}$

Number of Included Sheets