
## U.S. PUBLIC LAND SURVEY MONUMENT RECORD

For Public Land Survey Corners in the T. 4N., R. 14 E

CORNER CODE INDEX

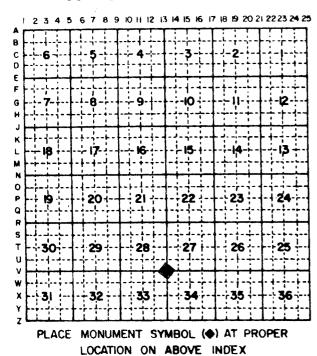

EXAMPLE ROCK COUNTY 'C/D-3/

> IF AVAILABLE STATE PLANE COORDINATES

Nor	th (Y)	Eleve. (Z)
Eas	t (X)	Zone
Hor	Datum	Vowa Datum

(a.)

CORNER MONUMENT

O WITNESS MONUMENT

D.O.T

MON. BERG Rd : STH-59

O = REBAR

1 : Guano Post

STH-59 3143-0-71 4-16-85 Swm SECTION COR.

FIELD BOOK PAGE #

SHOW A PLAN VIEW DRAWING DEPICTING THE CORNER MONUMENT AND SURROUNDING PHYSICAL FEATURES, INCLUDING THE EXCAVATION AREA AND DEPTH. THE CORNER MONUMENT SHALL HAVE THE FOLLOWING CHARACTERISTICS: I) HAVE AT LEAST TWO PREDETERMINED BREAK-OFF POINTS. 2) IF BROKEN, LEAVE A PERMANENTLY MAGNETIZED REMNANT AT THE ORIGINAL POINT. 3) MUST BE EXTENDABLE. 4) THE CAP IS INSCRIBED : ROCK COUNTY SURVEY MONUMENT - PENALTY FOR DISTURBING MARKER. 5) OR AN EXISTING CUT LIMESTONE. AN IRON PIPE IZ " X 4'0" (MINIMUM) MAY BE USED IN AREAS WHERE GROUND WATER IS WITHIN ONE FOOT OF THE SURFACE. IF THE CORNER IS OCCUPIED BY AN IMPROVEMENT (MANHOLE, BURIED CABLE, ETC.) ANY DURABLE, DISTINCT MONUMENT MAY BE USED. CORNERS SHALL BE REFERENCED WITH AT LEAST 4 DURABLE WITNESS MONUMENTS. WITNESS MONUMENTS SHALL BE MADE OF CONCRETE, NATURAL STONE, IRON OR OTHER EQUALLY DURABLE MATERIAL, EXCEPT WOOD. DESCRIBE THE CORNER AND THE WITNESS MONUMENTS. CORNER CODE:

V 13

(ъ.)	Describe any record evidence, monument evidence, occupational evidence, testimonial evidence or any other material evidence you considered, and whether the monument was found or placed.
(c.)	Was the corner restored through acceptance of (1) an obliterated evidence location, or, (2) a found perpetuated location?
( d.)	Describe any material discrepancy between the location of the corner as restored or reestablished and the location of that corner as previously restored or reestablished by distance and direction. Show the discrepancy on the plan view drawing under (a), above. Show the distances between the corner as previously restored or reestablished and (1) the corner as restored or reestablished, and (2) to at least 4 of the witness monuments shown on the drawing in (a), above.
1	Use the corner regetablished through lost corner are artispets methods? If an about the
( e.)	Was the corner reestablished through lost corner proportionate methods? If so, show the method, including the directions and distances to other public land survey corners used as evidence or used for proportioning in determining the corner location.
	I,, hereby certify that the corner points
	as identified by the corner code index were, in a field survey on
	, established, re-established, monumented, re-monumented, recovered or restored as expressed below and in conformance with the
	regulations and rules as required in the current manual of survey instructions of the United States Department of Interior, Bureau
	of Land Management.
	COUNTY SURVEYOR FILING DATA
	SEAL Date of Computer Entry
	Date Received Nov 20 1986
	Date Microfilmed
	Treasurer's Receipt No.
	Number of Included Sheets
	CORNER AFFIX YOUR LAND SURVEYOR SEAL CODE V13