
LAND SURVEY MONUMENT RECORD U.S. PUBLIC

For Public Land Survey Corners in the LIMA T. 4 N., R. 14 E.

CORNER CODE INDEX

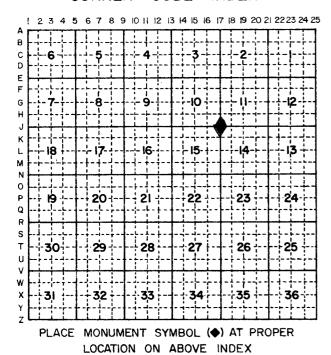


IF AVAILABLE STATE PLANE COORDINATES

North (Y) 298,764.45 Eleve. (Z) 907


East (X) 2317483.85 Zone SouTH

Hor. Datum _____ Vert. Datum

For Miscellaneous Corners within Sec.

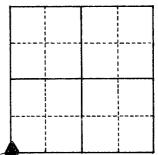

- Above code numbers are positioned 1. Meander, Claim, or Fractional corners of the section.
- Township corner code numbers shall be applied to the corners of above typical section.

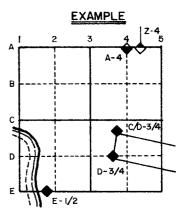

CORNER MONUMENT

O WITNESS MONUMENT



FOUND 1" IRON PIPE

UMA FIELD Book Page 49 REFERENCED IN VOL 3 Page 564



SHOW A PLAN VIEW DRAWING DEPICTING THE CORNER MONUMENT AND SURROUNDING PHYSICAL FEATURES, INCLUDING THE EXCAVATION AREA AND DEPTH. THE CORNER MONUMENT SHALL HAVE THE FOLLOWING CHARACTERISTICS: I) HAVE AT LEAST TWO PREDETERMINED BREAK-OFF POINTS. 2) IF BROKEN, LEAVE A PERMANENTLY MAGNETIZED REMNANT AT THE ORIGINAL POINT. 3) MUST BE EXTENDABLE. 4) THE CAP IS INSCRIBED : ROCK COUNTY SURVEY MONUMENT - PENALTY FOR DISTURBING MARKER. 5) OR AN EXISTING CUT LIMESTONE. AN IRON PIPE 1/2" x 4'0" (MINIMUM) WITH AT LEAST 4 DURABLE WITNESS MONUMENTS MAY BE USED IN AREAS WHERE GROUND WATER IS WITHIN 1.0' OF THE SURFACE. IF THE CORNER IS OCCUPIED BY AN IMPROVEMENT (MANHOLE, BURIED CABLE, ETC.), ANY DURABLE, DISTINCT MONUMENT MAY BE USED AND REFERENCED WITH AT LEAST 4 DURABLE WITNESS MONUMENTS.

	FOUND MONUMENT OF RECORD
Des	scribe any material discrepancy between the location of the
cor	ner as restored or re-established and the location of that ner as previously restored or re-established.
	the corner restored through acceptance of an obliterated dence location or a found perpetuated location.
	CCEPTED FOUND PERPETUATED LOCATION
	,
	
met dis	the corner re-established through lost corner proportionate hods? If so, show the method, including directions and tances to other public land survey corners used as evidence used for proportioning in determination of the corner location
	NO .
	NO
***	NO
	NO
	NO .
	NO .
as rec reg ins	NO Some former of the corner point identified by the corner code index were, in a field survey on the code index were c
as JU rec reg ins	nold Barres, hereby certify that the corner poin identified by the corner code index were, in a field survey on the corner code index were, in a field survey on the corner code index were, in a field survey on the corner code index were, in a field survey on the corner code index were, in a field survey on the conformance with the corner code in the corner code in the corner code in the corner pointies.
as JU rec reg ins	For lower point for that the corner point identified by the corner code index were, in a field survey on the formal point of the corner code index were, in a field survey on the constant of the conformance with the current manual of survestructions of the United States Department of Interior, Bureau Land Management.
as JU rec reg ins	noted barred, hereby certify that the corner point identified by the corner code index were, in a field survey on the corner code index were, in a field survey of the corner code index were considered in the corner code index were code
as JU rec reg ins	hereby certify that the corner poin identified by the corner code index were, in a field survey on the corner code index were, in a field survey on the constant of the constant of the conformance with the current manual of survestructions and rules as required in the current manual of survestructions of the United States Department of Interior, Bureau Land Management. COUNTY SURVEYOR FILING DATA Date of Computer Entry
as JU rec reg ins	note former of that the corner point identified by the corner code index were, in a field survey of the corner code index were, in a field survey of the corner code index were, in a field survey of the corner code index were, in a field survey of the corner code index were, in a field survey of the corner code in the consument of the conformance with the corner code in the conformance with the corner code in the conformance with the corner code in the conformance in the corner code in the co