
U.S. PUBLIC LAND SURVEY MONUMENT RECORD

For Public Land Survey Corners in LIMA TWP. T. 4 N., R. 14 E

CORNER CODE INDEX

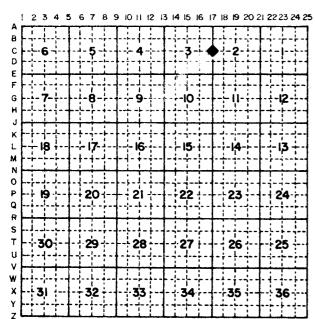

PLACE MONUMENT SYMBOL (♠) AT PROPER LOCATION ON ABOVE INDEX


IF AVAILABLE STATE PLANE COORDINATES

North (Y)306,706.93 Eleve. (Z)


East (X) 2,317,463.60 Zone <u>SOUTH</u>

Hor. Datum _____ Vert. Datum

For Miscellaneous Corners within Sec. _____, T. ____N., R. ____E.

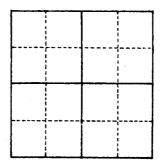


- Above code numbers are positioned Meander, Claim, or Fractional corners of the section.
- Township corner code numbers shall be applied to the corners of above typical section.

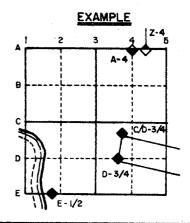

(a.)

CORNER MONUMENT
ALUMINUM (W-I-C) MONUMENT

○ WITNESS MONUMENT 3/8" x 24" IRON BOLT

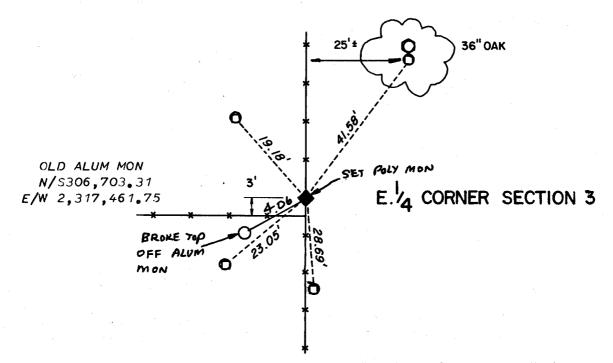

FIELD BOOK 3 PAGE # 17

SHOW A PLAN VIEW DRAWING DEPICTING THE CORNER MONUMENT AND SURROUNDING PHYSICAL FEATURES, INCLUDING THE EXCAVATION AREA AND DEPTH. THE CORNER MONUMENT SHALL HAVE THE FOLLOWING CHARACTERISTICS: 1) HAVE AT LEAST TWO PREDETERMINED BREAK-OFF POINTS. 2) IF BROKEN, LEAVE A PERMANENTLY MAGNETIZED REMNANT AT THE ORIGINAL POINT. 3) MUST BE EXTENDABLE. 4) THE CAP IS INSCRIBED: ROCK COUNTY SURVEY MONUMENT - PENALTY FOR DISTURBING MARKER. 5) OR AN EXISTING CUT LIMESTONE. AN IRON PIPE 1/2" x 4'0" (MINIMUM) MAY BE USED IN AREAS WHERE GROUND WATER IS WITHIN ONE FOOT OF THE SURFACE. IF THE CORNER IS OCCUPIED BY AN IMPROVEMENT (MANHOLE, BURIED CABLE, ETC.) ANY DURABLE, DISTINCT MONUMENT MAY BE USED. CORNERS SHALL BE REFERENCED WITH AT LEAST 4 DURABLE WITNESS MONUMENTS. WITNESS MONUMENTS SHALL BE MADE OF CONCRETE, NATURAL STONE, IRON OR OTHER EQUALLY DURABLE MATERIAL, EXCEPT WOOD. DESCRIBE THE CORNER AND THE WITNESS MONUMENTS.

CORNER CODE : C-17

VOL	5 PAGE 259	IN 19// SET	CORNER, SEE	COUNTY SURVEYOR'S RECORDS
			· ·	
) Was the o	corner restored through acreetuated location?	ceptance of (1) an obliterat	ed evidence location, or, (2) a
NO				
Describe	any material discrepancy l		*	
above. S and (1) t	shed and the location of common shed and direction. Show the show the distances between the corner as restored or shown on the drawing in the corner as restored or control or the drawing in the corner as restored or control or the drawing in the drawing in the corner as restored or control or con	he discrepancy the corner as reestablished.	on the plan v	iew drawing under (a),
	-			
THERE THIS IS	IS A DISCREPANCY BETWI S THE RESULT OF THE M	EEN THE CORN N CORNER OF	NER SET AND SEC 2 BEING	THE ONE SET IN 1977.
	A Company of the Comp	and the second section	\$	A Company of the Comp
method.	corner reestablished throu including the directions a	ugh lost corne	r nronartionate	
	or used for proportioning	and distances : g in determini	to other nuhlic	r land curvey corners used as
YES	e or used for proportioning	and distances g in determini	to other nuhlic	r land curvey corners used as
	or used for proportioning	and distances g in determini	to other public	c land survey corners used as location.
	or used for proportioning	and distances g in determini	other public of the corner 3003.00	c land survey corners used as location.
	or used for proportioning	and distances g in determini	to other public of the corner	or land survey corners used as location. NW COR SEC 2
	BEARINGS & DI	y in determini	other 54.15 NO 37 154.16 3020, 41 0 0 0 0 0 0 0 0 0 0 0 0 0 0 0 0 0 0	c land survey corners used as location.
	or used for proportioning	STANCES	5.30 3020,41 and 2640 OR 1G 3003,00 and 2640 OR 1G 3003,00 and 2001	or land survey corners used as location. NW COR SEC 2
	BEARINGS & DI ARE BASED ON	STANCES	154"E NO°37154"E at the constant of the consta	or land survey corners used as location. NW COR SEC 2
	BEARINGS & DI ARE BASED ON	STANCES A LOCAL	bug NO•37154"E NO•37154"E The operation of the control of the con	W 1/4 COR SEC 2
YES.	BEARINGS & DI ARE BASED ON DATUM Conclet for	STANCES A LOCAL	to deep other of the condition of the co	w 1/4 COR SEC 2 SW COR SEC 2 that the corner points in a field survey on
YES. I, as i MAY reco	BEARINGS & DI ARE BASED ON DATUM dentified by the co 23, 1983 , establi vered or restored a	STANCES A LOCAL Thereby orner code shed, re-e	to other public other public other public of the corner NO.37.154.1E N	W 1/4 COR SEC 2 SW COR SEC 2 that the corner points in a field survey on monumented, re-monumented in conformance with the
I, as i	BEARINGS & DI ARE BASED ON DATUM dentified by the co 23, 1983 , establi vered or restored a lations and rules a	STANCES A LOCAL Thereby orner code shed, re-es s expressed s required	to other public the corner public the corner of the corner	w 1/4 COR SEC 2 W 1/4 COR SEC 2 that the corner points in a field survey on monumented, re-monument in conformance with the corner manual of comments.
I, as i MAY recoreguinst	BEARINGS & DI ARE BASED ON DATUM dentified by the co 23, 1983 , establi vered or restored a lations and rules a	STANCES A LOCAL Thereby orner code shed, re-es s expressed s required	to other public the corner public the corner of the corner	W 1/4 COR SEC 2 SW COR SEC 2 that the corner points in a field survey on monumented, re-monumented in conformance with the
I, as i MAY recoreguinst	BEARINGS & DI ARE BASED ON DATUM dentified by the co 23, 1983 , establi evered or restored a lations and rules a ructions of the Uni	STANCES A LOCAL Thereby orner code shed, re-es s expresses required ted States	to other public the corner public the corner of the corner	w 1/4 COR SEC 2 W 1/4 COR SEC 2 that the corner points in a field survey on monumented, re-monumented in conformance with the crent manual of survey of Interior, Bureau
I, as i MAY recoreguinst	BEARINGS & DI ARE BASED ON DATUM dentified by the co 23, 1983 , establi evered or restored a lations and rules a ructions of the Uni	STANCES A LOCAL Thereby orner code shed, re-e s expresses required ted States	to other public the corner of	w 1/4 COR SEC 2 that the corner points in a field survey on monumented, re-monumented in conformance with the crent manual of survey of Interior, Bureau FILING DATA
I, as i MAY recoreguinst	BEARINGS & DI ARE BASED ON DATUM dentified by the co 23, 1983 , establi evered or restored a lations and rules a ructions of the Uni	STANCES A LOCAL Thereby Orner code shed, re-es s expresses required ted States COUNTY Date of	to other public the corner public the corner of the corner	w 1/4 COR SEC 2 that the corner points in a field survey on monumented, re-monumented in conformance with the crent manual of survey of Interior, Bureau FILING DATA
I, as i MAY recoreguinst	BEARINGS & DI ARE BASED ON DATUM dentified by the co 23, 1983 , establi evered or restored a lations and rules a ructions of the Uni	STANCES A LOCAL Thereby Priner code Shed, re-es S expressed ted States COUNTY Date of Date I	to other public the corner of	SW COR SEC 2 that the corner points in a field survey on monumented, re-monumen in conformance with the rent manual of survey of Interior, Bureau FILING DATA Entry
I, as i MAY recoreguinst	BEARINGS & DI ARE BASED ON DATUM dentified by the co 23, 1983 , establi evered or restored a lations and rules a ructions of the Uni	STANCES A LOCAL Thereby Priner code Shed, re-es Sexpresses Frequired ted States COUNTY Date Date Date Treasu	to other public the corner of	SW COR SEC 2 that the corner points in a field survey on monumented, re-monument in conformance with the rent manual of survey of Interior, Bureau FILING DATA Entry 10/15/1984 ipt No.