
U.S. PUBLIC LAND SURVEY MONUMENT RECORD

For Public Land Survey Corners in LIMA TWP. T. 4 N., R. 14 E.

For Miscellaneous Corners within Sec. 17, T. 4N., R. 4E.

CORNER CODE INDEX

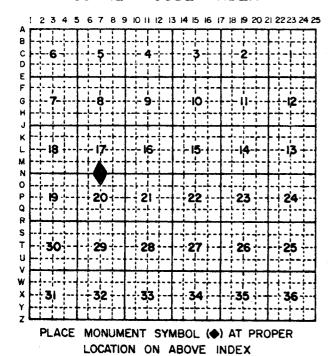

1. Above code numbers are positioned Meander, Claim, or Fractional corners of the section.

 Township corner code numbers shall be applied to the corners of above typical section.

IF AVAILABLE
STATE PLANE COORDINATES

North (Y) 293,935.32 Eleve. (Z) 879

East (X) 2304,096.16 Zone South

Hor. Datum _____ Vert. Datum

Hor. Datum _____ Vert. Datum ____

EXAMPLE

2 3 4 5

A-4

B

C

D

D-3/4

(a.)

CORNER MONUMENT

O WITNESS MONUMENT

3/8 1 28" IRON BOLT

ARINGS ARE BASED ON:

La. 52

13.55

14.56

FARM FIELD

16.04

FOUND IRON ROD WITH BOLT
ON TOP. I' DEEP REPLACED
WITH POLY MON. 15" DEEP

FIELD BOOK ___ PAGE # 12

SHOW A PLAN VIEW DRAWING DEPICTING THE CORNER MONUMENT AND SURROUNDING PHYSICAL FEATURES, INCLUDING THE EXCAVATION AREA AND DEPTH. THE CORNER MONUMENT SHALL HAVE THE FOLLOWING CHARACTERISTICS: I) HAVE AT LEAST TWO PREDETERMINED BREAK-OFF POINTS. 2) IF BROKEN, LEAVE A PERMANENTLY MAGNETIZED REMNANT AT THE ORIGINAL POINT. 3) MUST BE EXTENDABLE. 4) THE CAP IS INSCRIBED: ROCK COUNTY SURVEY MONUMENT - PENALTY FOR DISTURBING MARKER. 5) OR AN EXISTING CUT LIMESTONE. AN IRON PIPE I 1/2 " x 4'0" (MINIMUM) MAY BE USED IN AREAS WHERE GROUND WATER IS WITHIN ONE FOOT OF THE SURFACE. IF THE CORNER IS OCCUPIED BY AN IMPROVEMENT (MANHOLE, BURIED CABLE, ETC.) ANY DURABLE, DISTINCT MONUMENT MAY BE USED. CORNERS SHALL BE REFERENCED WITH AT LEAST 4 DURABLE WITNESS MONUMENTS. SHALL BE MADE OF CONCRETE, NATURAL STONE, IRON OR OTHER EQUALLY DURABLE MATERIAL, EXCEPT WOOD. DESCRIBE THE CORNER AND THE WITNESS MONUMENTS.

CORNER CODE:N >

(ъ.)	Day walter and				·					
D. 3	any other mate	record evidence, mom ≥rial eviden <mark>ce you</mark> o	considered,	and wh	ether t	he monume	ence, te ent was l	found o	r place	dence or d.
	FOUND 1º DEE	P IRON ROD WITH	BOLT THRU	J THE	TOP.	BLEEDH	ORN IN	1895	(VOL2	PG492)
	SET THE ROD.									
						-				
							7. * 			
		AMAGES OF THE STATE OF THE STAT								
(c.)	Was the corne	r restored through	acceptance o	of (1)	an obi	iterated (ev i dence	locat	i o n, or	, (2) a
	round perpetu	ated location?							e de la companya de l	
	ACCEPTED	CORNER AS FOUND	•							%
					11 To				•	
	0					S Abo com				v Na
(d.)	reestablished	material discrepanc and the location o nd direction. Show	f that corne	er as p	revious	sly restor	red or r	eestab	Lished	
	above. Show	the distances betwe orner as restored o	en the corne	er as p	revious	sly restor	red or r	eestab	Lished	
	monuments show	wn on the drawing i	n (a), above			and the		•		
		NE .				No. 12 April 5			e e e e e e e e e e e e e e e e e e e	
				** () J449541 ** 1 **						
	Δ	7 - 1								•
	and the second	en e			71 P.A. 2	and the second	r . a . Swale 1999		+ 7	4.1 g = 8
					-	·	e en			
(e.)	method, incl	er reestablished th uding the direction	is and distar	nces to	other	public 1.	and surv	lf so	, show the ners use	the ed as
	evidence or	used for proportion	ing in deter	rmining	the c	orner loc	ation.			
		NO								•
	I. Don	ald Barnes	, her	reby	certi	fy th	nat th	e cor	ner po	oints
	as iden	ntified by the	corner co	ode i	ndex	were,	in af.	ield	surve	v on
	recover	3/983 establed or restored	l as expre	re-es essed	tabli	shed, m wand i	nonume:	nted, forma	re-mo	onumented
	regulat	cions and rules	as requi	ired	in th	è curre	ent max	nual	of su	rvev
	of Land	tions of the U Management.	nited Sta	ates	Depar	tment o	of Int	erior	, Bure	eau
					_					
	100					EYOR FI		DATA		
			1			puter F	Entry			
	<u> </u>				eceiv					
			217 B		S	ilmed _	10/	15	198	4_
			/ · · · · ·			Receip		5.7		
			Nu	ımber	of I	ncluded	Sheet	ts		
								4 4 5 5		

AFFIX YOUR LAND SURVEYOR SEAL. N