U.S.

SURVEY TUBLIC MONUMENT RECORD

For	Public Land	Survey	Corners	in	the
	TAN.,	R. 14	_E		

CORMER CODE INDEX

7 8 910111213141516171819202122232425 В 7 6 12 10 8 Ò. J M L M H O P O R S T 11 14 18 10 23 22 Q_S 26 28 Q. 34 zb.

LIMA	TWE	
ROCK	COUNTY	WI

IF AVAILABLE ROCK COUNTY COORDINATES PERFERRED North Elev.

East

Hor. Datum _____ Vert. Datum ____

GPS (X) ____ TRAVERSE (X) ____

BASED ON THE FOLLOWING CONTROL:

AT PROPER

PLACE MONUMENT SYMBOL • LOCATION ON ABOVE INDEX

CORNER MONUMENT

O WITHESS MONUMENT

(a)

BEARINGS ARE BASED ON:

FIELD BOOK

PAGE #

SHOW A PLAN VIEW DRAWING DEPICTING THE COTHER MOLUMENT ALD SUPPOINDING PHYSICAL FEATURES, INCLIDING THE EXCAVATION AREA AND DEPTH. THE CORNER MOLUMENT SHALL HAVE SHOWN CHARGING DEPICTING THE COLOR ROLLERS TWO PRODUCENTS OF POINTS. 21 IF BROKER LEAVE A PERHAMENTLY MAGNETIZED REMAINT AT THE ORIGINAL POINT. THE FOLLOWING CHARGING IS 11 HAVE A LEAST TWO PRODUCENTS OF POINTS. 21 IF BROKER A PERHAMENTLY MAGNETIZED REMAINT AT THE ORIGINAL POINT. 31 MUST BE EXTENDABLE. 4) THE CAP IS INSCRIBED TROCK COUNTY SURVEY MONUMENT - PENALTY FOR DISTURBING MARKER. 5) OR AN EXISTING CUT LINESTOILE. AN IRON PIPE 1 1/2"Y 4. DISTURD THE AREA WERE CROWN ANABER IS WITHOUT OF THE SURFACE. IF THE CORNER IS COCLIDED BY AN INTERPOVENENT BIAN-PLEBURIED CABLECTO AND DRABLE, OISTINGT MOLUMENT MAY BE USED. COTHERS SHALL BE REFERENCED WITH AT LEAST 4 DURBLE WITHESS MONUMENTS. WITHESS MONUMENTS SHALL BE MADE OF CONCRETE, HATUTAL STOKE, BROKE EDUCATION OF THE SURFACE. IF WE CORNER SHALL BE MODE OF CONCRETE, HATUTAL STOKE, BROKE EDUCATION OF THE SURFACE. IF WE CORNER SHALL BE MODE OF CONCRETE, HATUTAL STOKE, BROKE EDUCATION OF THE SURFACE. IF WE CORNER AND THE WITHESS MONUMENTS. WITHESS MONUMENTS SHALL BE MADE OF CONCRETE. HATUTAL STOKE, BROKE EDUCATION OF THE SURFACE. IF WE CORNER AND THE WITHESS MONUMENTS. SHEET _ OF 3

PLAINING & ZOMINO COMMITTEE ADOPTED THE ABOVE FORM ON 12/2/1982 WI ADMINISTRATIVE CODE A-E 7.08 REQUIREMENT

CORNER CODE

LI584 S 1/4 COR SEC 20

(B) Describe any record evidence, monument evidence, occupational evidence, testimonial evidence or any other material evidence you considered, and whether the monument was found or placed.

1836 BURNHAM EAST RANDOM BETWEEN 20 &29

4356 LEAVE WET PRAIRIE

5346 INT. EAST BDY AT STAKE

MOSTLY WET PRAIRIE

WEST MARKED LINE BETWEEN 29 & 20

2673 1/2 S IN MARSH NO BEARINGS

5346 TO CORNER

1886 RUGER VOL 2 PG 281 EST. COR CALLS FOR A VAR OF 3-05' & 2692.39' TO THE SE & SW CORNERS OF SEC 20 & 5324.72' TO THE N 1/4 COR SEC 20.

THERE IS A LOT OF WATER. RUGER'S VARIATION INDICATES THAT HE ESTABLISHED THE CORNER MIDWAY ON LINE BETWEEN THE SE & SW CORNERS OF SEC 20. I ESTABLISHED THE CORNER MIDWAY AND ON LINE BETWEEN THE SW & SE CORNERS OF SEC 20. THIS IS ALSO IN HARMONY WITH RUGER'S DISTANCE TO THE N 1/4 CORNER OF SEC 20. PLACED A BERNTSEN TOP SECURITY ROD THAT IS 9' LONG.

- C) Was the corner restored through acceptance of (1) an obliterated evidence location, or, (2) a found perpetuated location?
 THE CORNER WAS RESTORED THROUGH ACCEPTANCE OF OBLITERATED EVIDENCE LOCATION.
- D) Describe any material discrepancy between the location of the corner as restored or reestablished and the location of that corner as previously restored or reestablished by distance and direction. Show the discrepancy on the plan view drawing under (a), above. Show the distances between the corner as previously restored or reestablished and (1) the corner as restored or reestablished, and (2) to at least 4 of the witness monuments shown on the drawing in (a), above.
- (E) Was the corner reestablished through lost corner proportionate methods? If so, show the method, including the directions and distances to other public land survey corners used as evidence or used for proportioning the corner location.

I, Donald Barnes, hereby certify that the corner points as identified by the corner code index were, in a field survey on, February 12, 1996, established, re-established, monumented, re-monumented, recovered or restored as expressed below and in conformance with the regulations and rules as required in the current manual of survey instructions of the United States Department of Interior, Bureau of Land Management.

Doseal / Barnes 2/14/1996 COUNTY SURVEYOR FILING DATA


Date of computer entry_____

Date microfilmed

Number of included sheets 2 CORNER CODE


EMBOSS LAND SURVEYOR SEAL

A-E 7.08 REQUIREMENT

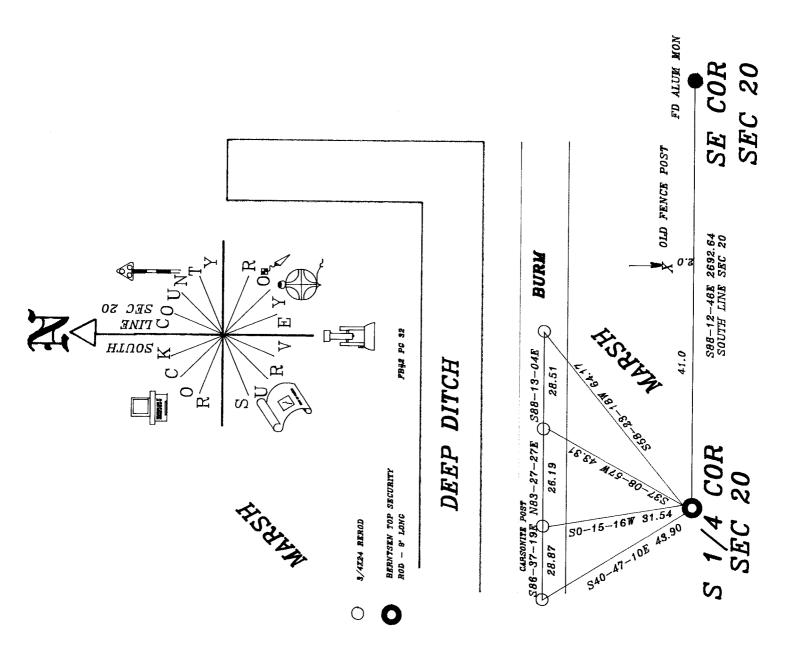

Donald Baines 2/14/1996

2 of 3

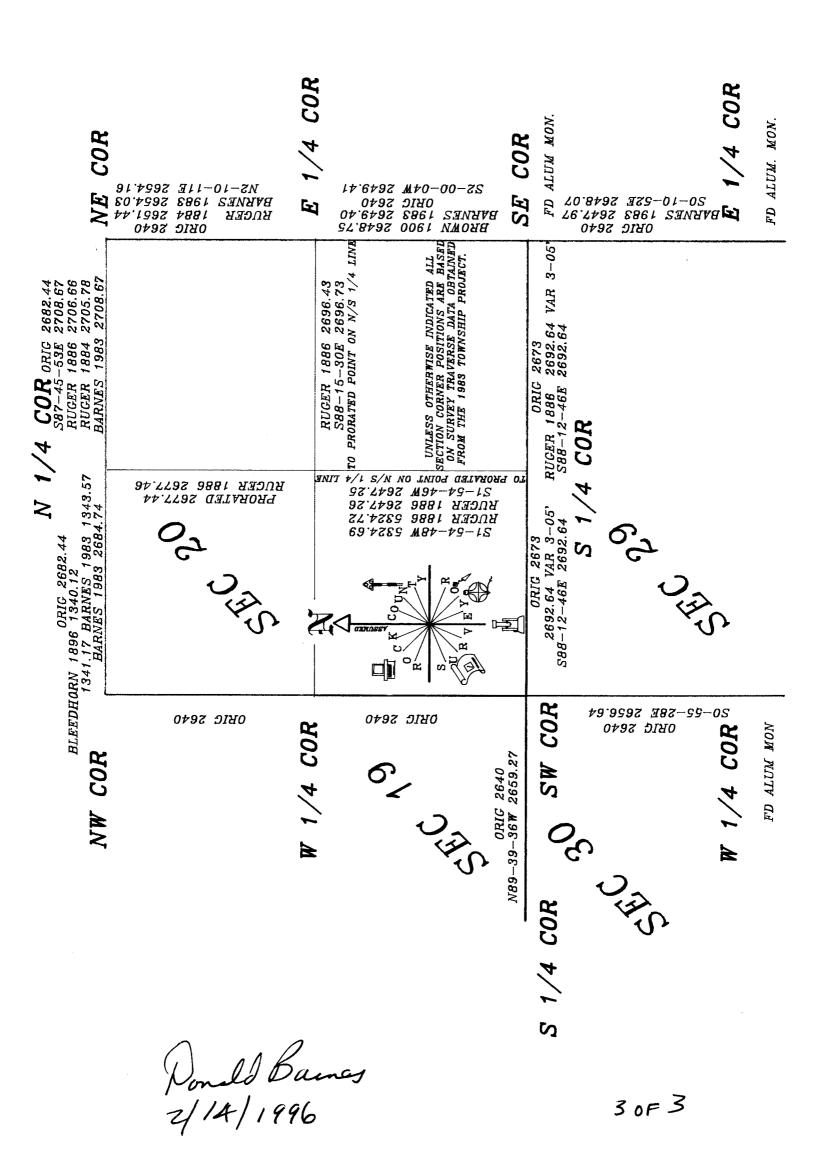

R7