
## SURVEY MONUMENT RECORD U.S. PUBLIC LAND

For Public Land Survey Corners in the UMA

T. 4 N., R. 14 E.


CORNER CODE INDEX

For Miscellaneous Corners within Sec. <u>5, T. 4 N., R. 14 E.</u>

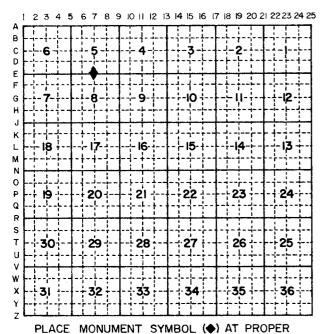

Above code numbers are positioned Meander, Claim, or Fractional corners of the section.

Township corner code numbers shall be applied to the corners of above typical section.

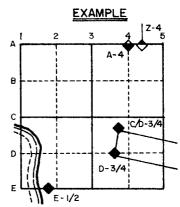


IF AVAILABLE STATE PLANE COORDINATES

North (Y) 374521.29 Eleve. (Z)

LOCATION ON ABOVE INDEX

East (X) 2,304, 1/6.15 Zone

Hor. Datum \_\_\_\_\_ Vert. Datum

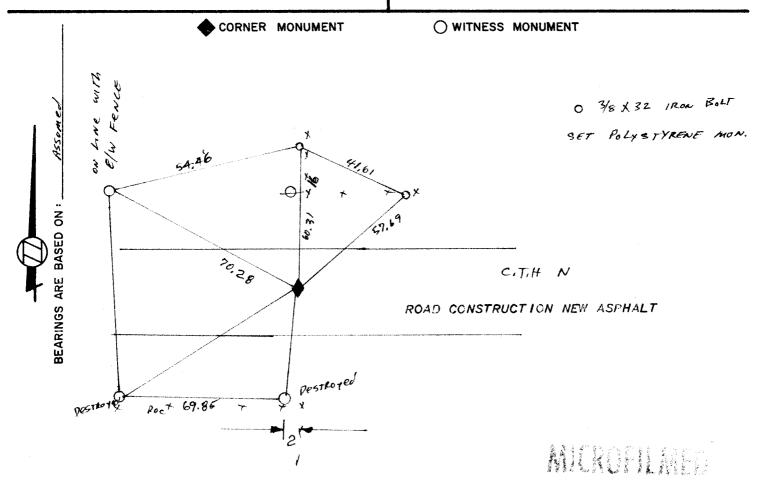

SHOW A PLAN VIEW DRAWING DEPICTING THE CORNER MONUMENT AND SURROUNDING PHYSICAL FEATURES, INCLUDING THE EXCAVATION AREA AND DEPTH. THE CORNER MONUMENT SHALL HAVE THE FOLLOWING CHARACTERISTICS: 1) HAVE AT LEAST TWO PREDETERMINED BREAK-OFF POINTS. 2) IF BROKEN, LEAVE A PERMANENTLY MAGNETIZED REMNANT AT THE ORIGINAL POINT. 3) MUST BE EXTENDABLE. 4) THE CAP IS INSCRIBED ROCK COUNTY SURVEY MONUMENT - PENALTY FOR DISTURBING MARKER. 5) OR AN EXISTING CUT LIMESTONE. AN IRON PIPE 1 2" x 4'0" (MINIMUM) WITH AT LEAST 4 DURABLE WITNESS MONUMENTS MAY BE USED IN AREAS WHERE GROUND WATER IS WITHIN I.O' OF THE SURFACE. IF THE CORNER IS OCCUPIED BY AN IMPROVEMENT (MANHOLE, BURIED CABLE, ETC.), ANY DURABLE, DISTINCT MONUMENT MAY BE USED AND REFERENCED WITH AT LEAST 4 DURABLE WITNESS MONUMENTS.

2

+00	IND TIES ON NORTH SIDE OF ROAD AS SET PRIOR TO ROAD CONSTRUCTION.
corr	cribe any material discrepancy between the location of the ner as restored or re-established and the location of that ner as previously restored or re-established.
	NONE
evid	the corner restored through acceptance of an obliterated lence location or a found perpetuated location.
AC	CEPTANCE OF TIES
Was	the corner re-established through lost corner proportionate
dist	nods? If so, show the method, including directions and ances to other public land survey corners used as evidence sed for proportioning in determination of the corner location
dist or u	ances to other public land survey corners used as evidence
dist or u	ances to other public land survey corners used as evidence
dist or u	ances to other public land survey corners used as evidence
I, wo instruction	Downlow frames, hereby certify that the corner point dentified by the corner code index were, in a field survey or established, re-established, monumented, re-monur vered or restored as expressed below and in conformance with
I, no in the control of the control	Ances to other public land survey corners used as evidence ised for proportioning in determination of the corner location.  Devol Romes , hereby certify that the corner point dentified by the corner code index were, in a field survey or established, re-established, monumented, re-monumered or restored as expressed below and in conformance with lations and rules as required in the current manual of survey ructions of the United States Department of Interior, Bureau
I, no i	Ances to other public land survey corners used as evidence used for proportioning in determination of the corner location of the corner point dentified by the corner code index were, in a field survey or location, established, re-established, monumented, re-monum vered or restored as expressed below and in conformance with lations and rules as required in the current manual of survey ructions of the United States Department of Interior, Bureau and Management.  COUNTY SURVEYOR FILING DATA  Date of Computer Entry
I, wo instruction	Ances to other public land survey corners used as evidence sed for proportioning in determination of the corner location of the corner location of the corner location of the corner location dentified by the corner code index were, in a field survey on the corner code index were, in a field survey on the location of the corner code index were, in a field survey of the corner code index were, in a field survey of the corner code index were, in a field survey of the location of the location of the location of the corner code index were, in a field survey of the location of the location of the location of the corner code index were, in a field survey of the location of the location of the corner code index were, in a field survey of the location of the location of the location of the corner code index were, in a field survey of the location of the location of the location of the corner code index were, in a field survey of the location of the locat
I, no in the control of the control	Ances to other public land survey corners used as evidence sed for proportioning in determination of the corner location of the corner point dentified by the corner code index were, in a field survey or location of location of the corner code index were, in a field survey or location or restored as expressed below and in conformance with lations and rules as required in the current manual of survey ructions of the United States Department of Interior, Bureau and Management.  COUNTY SURVEYOR FILING DATA  Date of Computer Entry  Date Received  Date Microfilmed  10/15/1984
NO NO instance instan	Ances to other public land survey corners used as evidence sed for proportioning in determination of the corner location of the corner location of the corner location of the corner location dentified by the corner code index were, in a field survey or location of the corner code index were, in a field survey or location of the location of location

affix your land surveyor seal. E7