
## U.S. PUBLIC LAND SURVEY MONUMENT RECORD

For Public Land Survey Corners in <u>LIMA</u> TWP. T. <u>A.</u> N., R. <u>IA</u> E. For Miscellaneous Corners within Sec. 27, T. 4 N., R. 14 E.

CORNER CODE INDEX

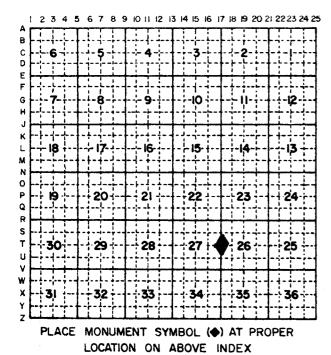

1. Above code numbers are positioned Meander, Claim, or Fractional corners of the section.

 Township corner code numbers shall be applied to the corners of above typical section.


IF AVAILABLE

STATE PLANE COORDINATES

North (Y)285,541.70 Eleve. (Z) 930

East (X) 2,313441.12 Zone

Hor. Datum Vert. Datum

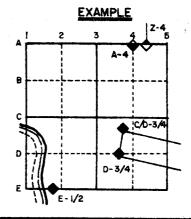

(a.)

CORNER MONUMENT

O WITNESS MONUMENT

EARINGS ARE BASED ON:

X
X
X
X
Fd ALUM MON AS REFERENCED
IN VOL 5 page, 290 SET CARSONITE
POST.
X

FIELD BOOK \_\_\_ PAGE # 6

SHOW A PLAN VIEW DRAWING DEPICTING THE CORNER MONUMENT AND SURROUNDING PHYSICAL FEATURES, INCLUDING THE EXCAVATION AREA AND DEPTH. THE CORNER MONUMENT SHALL HAVE THE FOLLOWING CHARACTERISTICS: 1) HAVE AT LEAST TWO PREDETERMINED BREAK-OFF POINTS. 2) IF BROKEN, LEAVE A PERMANENTLY MAGNETIZED REMNANT AT THE ORIGINAL POINT. 3) MUST BE EXTENDABLE. 4) THE CAP IS INSCRIBED: ROCK COUNTY SURVEY MONUMENT - PENALTY FOR DISTURBING MARKER. 5) OR AN EXISTING CUT LIMESTONE. AN IRON PIPE 1 × x 4'0" (MINIMUM) MAY BE USED IN AREAS WHERE GROUND WATER IS WITHIN ONE FOOT OF THE SURFACE. IF THE CORNER IS OCCUPIED BY AN IMPROVEMENT (MANHOLE, BURIED CABLE, ETC.) ANY DURABLE, DISTINCT MONUMENT MAY BE USED. CORNERS SHALL BE REFERENCED WITH AT LEAST 4 DURABLE WITNESS MONUMENTS. SHALL BE MADE OF CONCRETE, NATURAL STONE, IRON OR OTHER EQUALLY DURABLE MATERIAL, EXCEPT WOOD. DESCRIBE THE CORNER AND THE WITNESS MONUMENTS.

χ

CORNER CODE: 7-19

(ъ.)	Describe any record evidence, monum any other material evidence you con	ent evidence, occupational evidence, testimonial evidence or sidered, and whether the monument was found or placed.
e.	FOUND ALUM MON.	
	•	
(c.)		ceptance of (1) an obliterated evidence location, or, (2) a
	found perpetuated location?  ACCEPTED MON.	
	ACCEPTED MON.	
( d.)	reestablished and the location of t by distance and direction. Show the above. Show the distances between	netween the location of the corner as restored or chat corner as previously restored or reestablished ne discrepancy on the plan view drawing under (a), the corner as previously restored or reestablished reestablished, and (2) to at least 4 of the witness a), above.
		gagan gang gang kanada kan mengang bermanan kan mengangkan kemilik di dalah mengan bermanan kemilik bermanan k Mengan
	. sa r	
٠		
( e.)	method, including the directions a	igh lost corner proportionate methods? If so, show the and distances to other public land survey corners used as a in determining the corner location.
	as identified by the co  APRIL 291983 establi  redovered or restored a  regulations and rules a	, hereby certify that the corner points orner code index were, in a field survey on shed, re-established, monumented, re-monumented expressed below and in conformance with the srequired in the current manual of survey ted States Department of Interior, Bureau
	g with the grant	COUNTY SURVEYOR FILING DATA
		Date of Computer Entry
		Date Received
		Date Microfilmed 10/167/984
		Treasurer's Receipt No.
		Number of Included Sheets

AFFIX YOUR LAND SURVEYOR SEAL. T/7