

MICROFILMED PLAT AND RECORD

CITY OF JANESVILLE

Of a Survey on Section 19 T 2 R 14 E. of the 4 P. M. in Bradford Township

Rock County, Wisconsin, made _____ the _____ 19__


I hereby certify that the following is a correct record of said survey ~~as made by me~~

COUNTY BUILDING
CITY OF JANESVILLE

(Signed) P. F. Brown
R. H. B.

County Surveyor.

Taken from notes of O. G. Bleedorn.

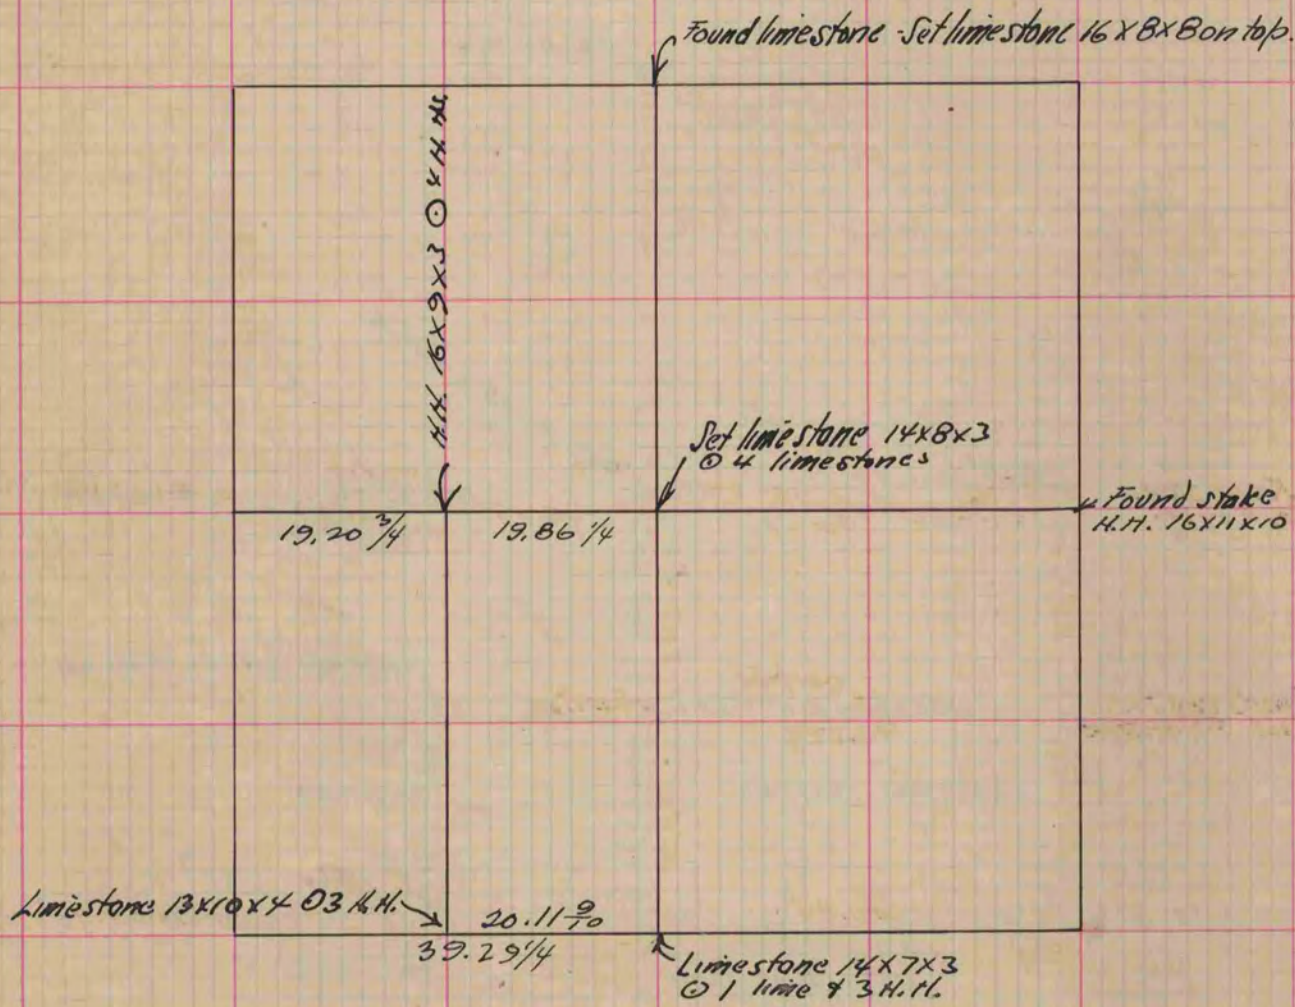

Copied from P. 383 Vol. 2. County Surveyors Record.