

# PLAT AND RECORD

COUNTY BUILDING  
CITY OF JANESVILLE

COUNTY BUILDING  
CITY OF JANESVILLE


Of a Survey on Section 16 T 2 N R 14 E. of the 4 P. M. in BRADFORD Township

Rock County, Wisconsin, made JUNE the 15 1971

I hereby certify that the following is a correct record of said survey as made by me.

**MICROFILMED**

*Hugh J. See*  
County Surveyor.

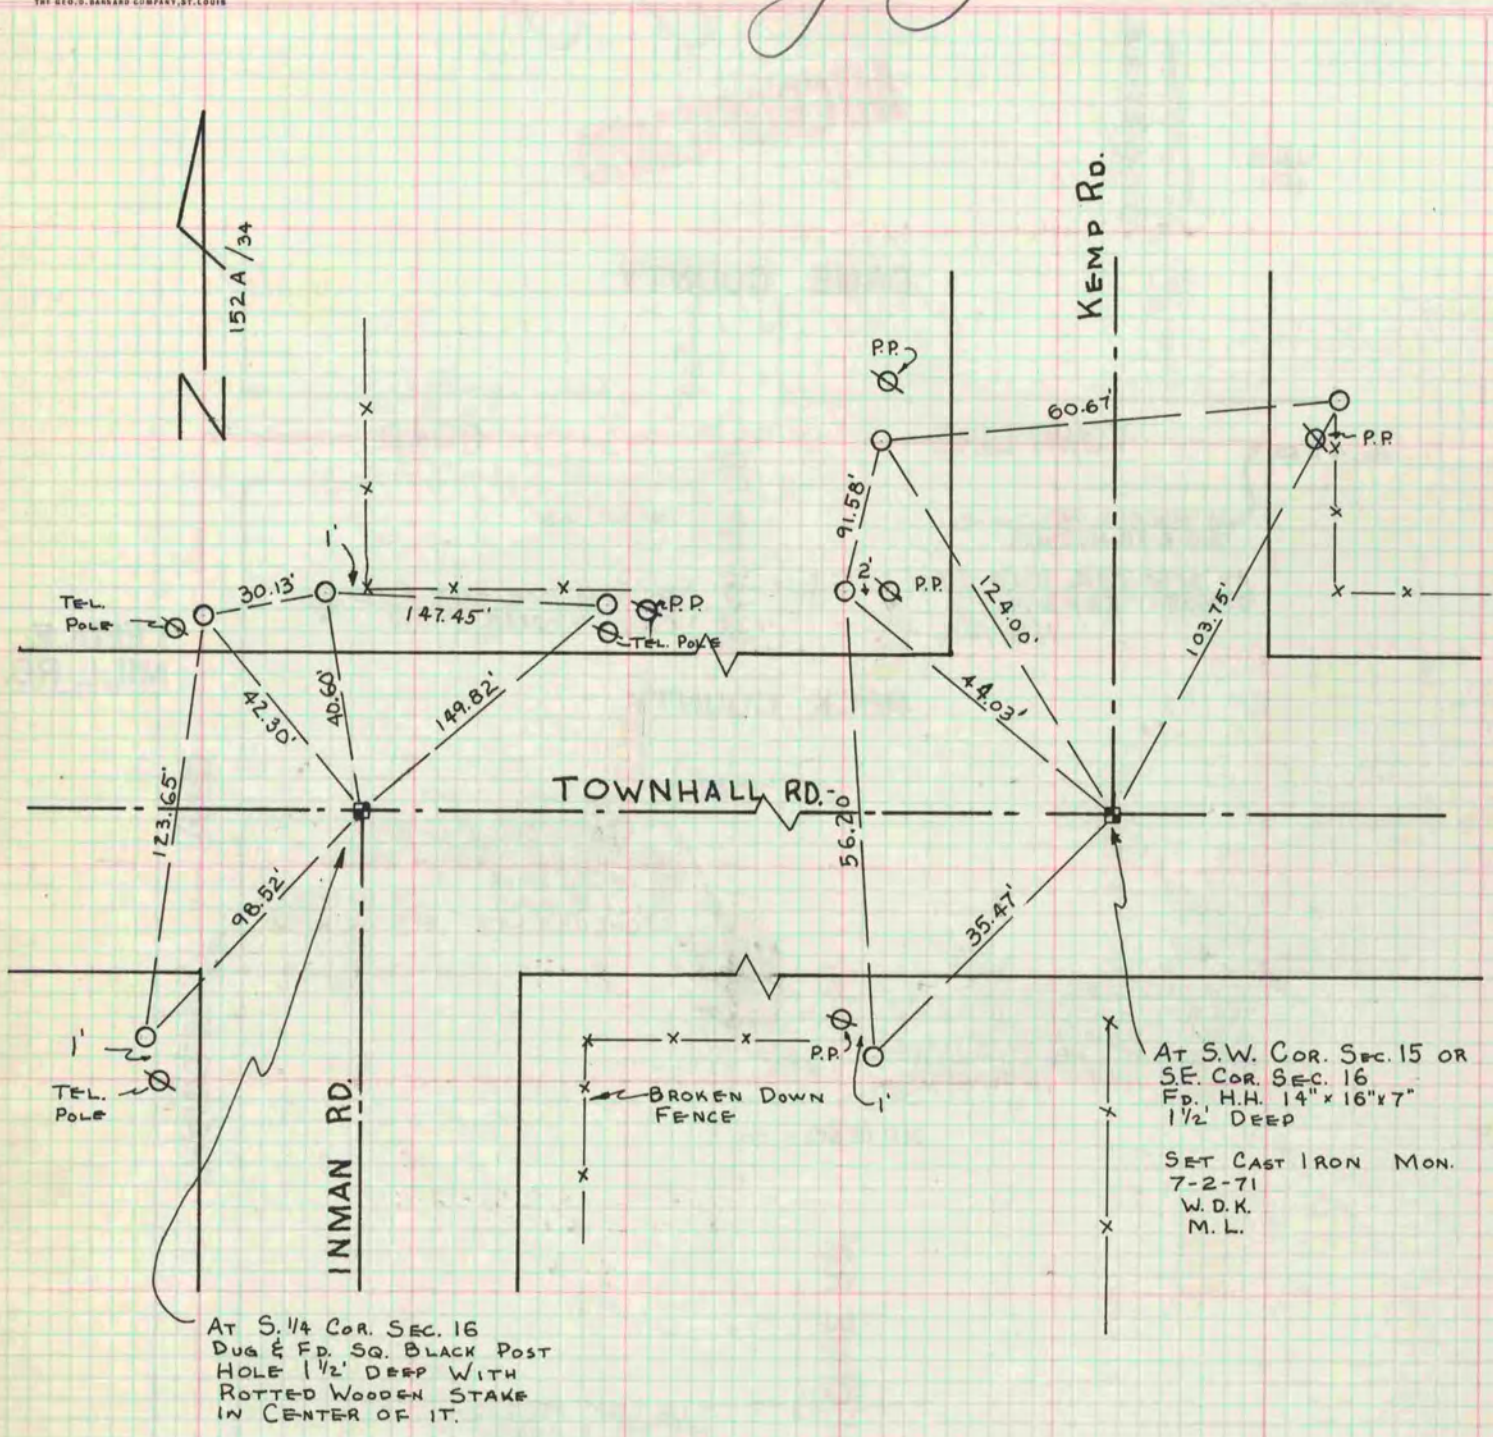

NOTE: O = 1" x 24" IRON PIPE

J.M.S.  
J.E.L.