

Of a Survey on Section 8 T 2N., R 14 E. of the 4 P. M. in

BRADFORD

Rock County, Wisconsin, made April the 1

I hereby certify that the following is a correct record of said survey as made by me

COUNTY BUILDING CITY OF JANESVILLE



N. 1/4 CORNER - SECTION 8


524

Dug 3' x 3' x 3' hole at mid-point and on line with the N.E. and N.W. corners of Section 8 - found nothing.

Dug 2' x 3' x 3.5' hole at a point by projecting line and distance between the N.E. corner and the N. 1/16 of the N.E. 1/4 of Section 8 to the west - found nothing.

PROJECTION OF THE NE COR U.S.H. 14 & THE REC 1/16th COR FOUND OLD PATCH


DUG & FOUND NOTHING 3.5 DEEP FOUND BEDROCK

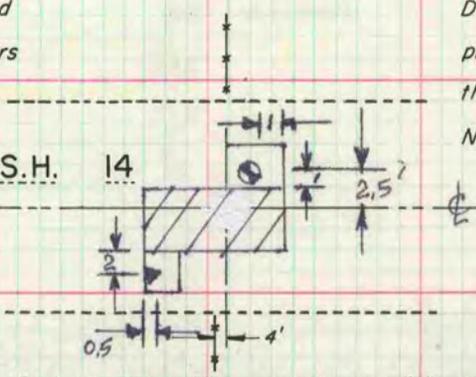

Set Polystyrene Monument at mid-point and on line with the N.E. and N.W. corners of Section 8. Reference: Volume 3, Page 99. Field Book: Bradford, Page 13.

MICROFILMED

N. 1/16 CORNER OF THE N.E. 1/4 - SECTION 8

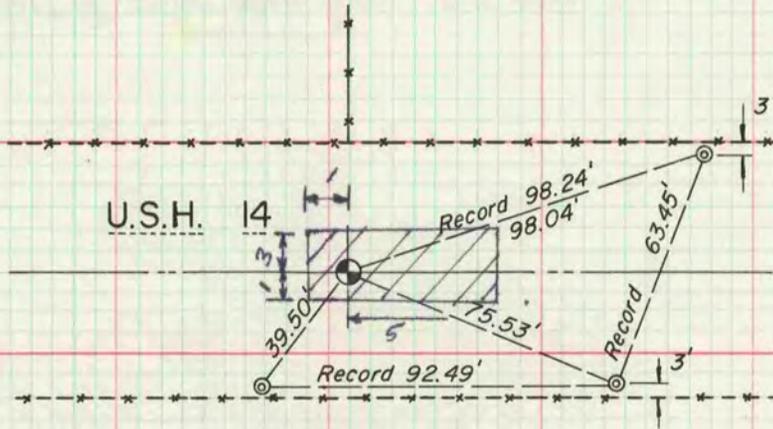

Found P.K. nail in pavement and 1" iron pipe reference monuments. Reference: Volume 4, Page 514. Field Book: Bradford, Page 13.

