
## U.S. PUBLIC LAND SURVEY MONUMENT RECORD

For Public Land Survey Corners in the T. 4 N., R. 14 E. LIMA TOP

CORNER CODE INDEX

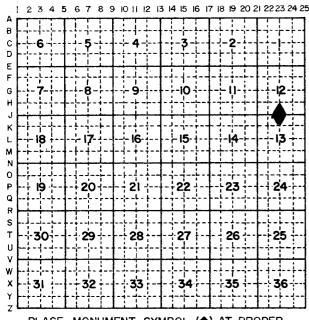

PLACE MONUMENT SYMBOL (♦) AT PROPER LOCATION ON ABOVE INDEX


IF AVAILABLE STATE PLANE COORDINATES

North (Y)**298,632.2**1 Eleve. (Z) 908


East (X) 2325,464,48 Zone South

Hor. Datum \_\_\_\_\_ Vert. Datum

For Miscellaneous Corners within Sec. 12, T.4, N., R. 14, E.

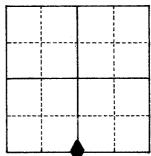


- 1. Above code numbers are positioned Meander, Claim, or Fractional corners of the section.
- 2. Township corner code numbers shall be applied to the corners of above typical section.

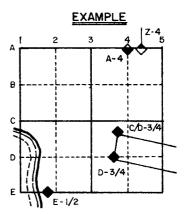

CORNER MONUMENT

O WITNESS MONUMENT

3/84X324 IRON BOLT TRAVERSE STATION

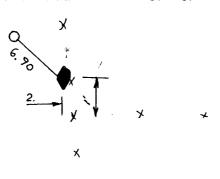


SET CHRSCHITE WITH SIGN

LIMA SIELD BOOK Page 68

MICKELLAND

SHOW A PLAN VIEW DRAWING DEPICTING THE CORNER MONUMENT AND SURROUNDING PHYSICAL FEATURES, INCLUDING THE EXCAVATION AREA AND DEPTH. THE CORNER MONUMENT SHALL HAVE THE FOLLOWING CHARACTERISTICS: I) HAVE AT LEAST TWO PREDETERMINED BREAK-OFF POINTS. 2) IF BROKEN, LEAVE A PERMANENTLY MAGNETIZED REMNANT AT THE ORIGINAL POINT. 3) MUST BE EXTENDABLE. 4) THE CAP IS INSCRIBED: ROCK COUNTY SURVEY MONUMENT - PENALTY FOR DISTURBING MARKER. 5) OR AN EXISTING CUT LIMESTONE. AN IRON PIPE 1/2" x 4'0" (MINIMUM) WITH AT LEAST 4 DURABLE WITNESS MONUMENTS MAY BE USED IN AREAS WHERE GROUND WATER IS WITHIN 1.0' OF THE SURFACE. IF THE CORNER IS OCCUPIED BY AN IMPROVEMENT (MANHOLE, BURIED CABLE, ETC.), ANY DURABLE, DISTINCT MONUMENT MAY BE USED AND REFERENCED WITH AT LEAST 4 DURABLE WITNESS MONUMENTS.

FOUND 1/2"	TRON THE THAT WAS SETTO SHIMEAL. REPLACED WITH PVC MON.
THIS \$48 IN	HARMONY WITH HIS CALL DISTANCE TO THE IRON OIN IN THE RO
7/40 E 437. /	IT WAS ALSO IN HARMONY WITH RUGER'S CALL DISTANCE TO THE
corner as res	material discrepancy between the location of the stored or re-established and the location of that eviously restored or re-established.
Was the corne	er restored through acceptance of an obliterated
evidence loca	ation or a found perpetuated location.
evidence loca	ation or a found perpetuated location.
evidence loca Was the corne methods? If distances to	er re-established through lost corner proportionate so, show the method, including directions and other public land survey corners used as evidence proportioning in determination of the corner location.
evidence loca Was the corne methods? If distances to	er re-established through lost corner proportionate so, show the method, including directions and other public land survey corners used as evidence
was the cornemethods? If	er re-established through lost corner proportionate so, show the method, including directions and other public land survey corners used as evidence
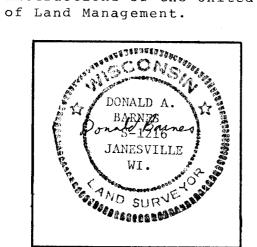

COUNTY SURVEYOR FILING DATA		
Date of Computer Entry		
Date Received		
Date Microfilmed 10/15/1984		
Treasurer's Receipt No.		
Number of Included Sheets		

affix your land surveyor seal. J23