
LAND SURVEY MONUMENT U.S. PUBLIC RECORD

For Public Land Survey Corners in the T. 4 N., R. 14 E. LIMA

CORNER CODE INDEX

For Miscellaneous Corners within Sec. <u>15</u>,T. 4 N., R. <u>14</u> E.

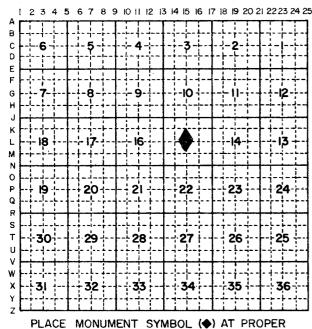

Above code numbers are positioned 1. Meander, Claim, or Fractional corners of the section.


Township corner code numbers shall be applied to the corners of above typical section.

EXAMPLE

IF AVAILABLE STATE PLANE COORDINATES North (Y)296,243.70 Eleve. (Z) 883

LOCATION ON ABOVE INDEX

Hor. Datum _____ Vert. Datum

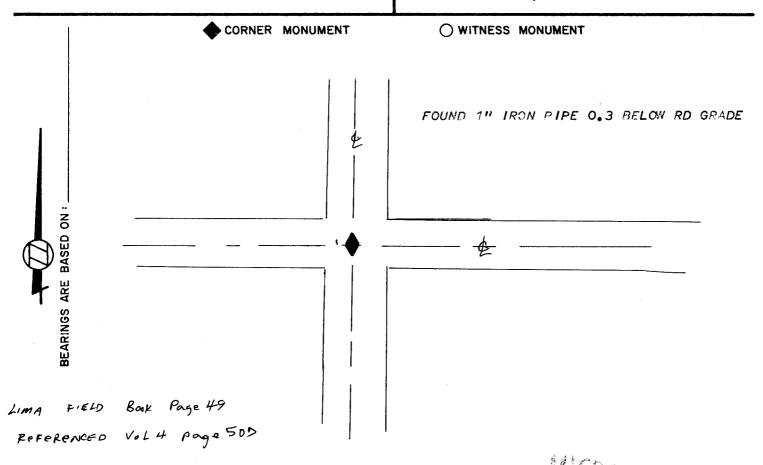

SHOW A PLAN VIEW DRAWING DEPICTING THE CORNER MONUMENT AND SURROUNDING PHYSICAL FEATURES, INCLUDING THE EXCAPATION AREA AND DEPTH. THE CORNER MONUMENT SHALL HAVE THE FOLLOWING CHARACTERISTICS: I) HAVE AT LEAST TWO PREDETERMINED BREAK-OFF POINTS. 2) IF BROKEN, LEAVE A PERMANENTLY MAGNETIZED REMNANT AT THE ORIGINAL POINT. 3) MUST BE EXTENDABLE. 4) THE CAP IS INSCRIBED : ROCK COUNTY SURVEY MONUMENT - PENALTY FOR DISTURBING MARKER. 5) OR AN EXISTING CUT LIMESTONE. AN IRON PIPE 1 2" x 4'0" (MINIMUM) WITH AT LEAST 4 DURABLE WITNESS MONUMENTS MAY BE USED IN AREAS WHERE GROUND WATER IS WITHIN 1.0' OF THE SURFACE. IF THE CORNER IS OCCUPIED BY AN IMPROVEMENT (MANHOLE, BURIED CABLE, ETC.), ANY DURABLE, DISTINCT MONUMENT MAY BE USED AND REFERENCED WITH AT LEAST 4 DURABLE WITNESS MONUMENTS.

> CORNER CODE: 15

	FOUND MONUMENT OF RECORD
D	
cor	scribe any material discrepancy between the location of the rner as restored or re-established and the location of that oner as previously restored or re-established.
Was evi	the corner restored through acceptance of an obliterated dence location or a found perpetuated location.
	ACCEPTED FOUND PERPETUATED LOCATION
	·
	<u> </u>
·····	
Was	the corner re-established through lost corner proportionate
met dis	chods? If so, show the method, including directions and stances to other public land survey corners used as evidence
met dis	chods? If so, show the method, including directions and stances to other public land survey corners used as evidence used for proportioning in determination of the corner location
met dis	chods? If so, show the method, including directions and stances to other public land survey corners used as evidence used for proportioning in determination of the corner location
metdisor I, as Vor recgins	chods? If so, show the method, including directions and stances to other public land survey corners used as evidence used for proportioning in determination of the corner location
metdis I, Isologians	hods? If so, show the method, including directions and stances to other public land survey corners used as evidence used for proportioning in determination of the corner location to the corner location to the corner location to the corner point identified by the corner code index were, in a field survey of the corner code index w
metdis I, Isologians	hods? If so, show the method, including directions and stances to other public land survey corners used as evidence used for proportioning in determination of the corner location not be corner location. NO NO hereby certify that the corner point identified by the corner code index were, in a field survey of the corner code ind
metdis I, Isologians	NO
metdisor I, as Vecregins	Local banes , hereby certify that the corner point identified by the corner code index were, in a field survey overed or restored as expressed below and in conformance with ulations and rules as required in the current manual of survey tructions of the United States Department of Interior, Bureau Land Management. COUNTY SURVEYOR FILING DATA Date of Computer Entry Date Received
metdisor I, as Vecregins	Forel' Banes , hereby certify that the corner point identified by the corner code index were, in a field survey over 1987 , established, re-established, monumented, re-monumovered or restored as expressed below and in conformance with ulations and rules as required in the current manual of survey tructions of the United States Department of Interior, Bureau Land Management. COUNTY SURVEYOR FILING DATA Date of Computer Entry Date Received Date Microfilmed 10/15/1984
metdisor I, as Vecregins	Local Banes , hereby certify that the corner point identified by the corner code index were, in a field survey overed or restored as expressed below and in conformance with ulations and rules as required in the current manual of survey tructions of the United States Department of Interior, Bureau Land Management. COUNTY SURVEYOR FILING DATA Date of Computer Entry Date Received