
U.S. PUBLIC LAND SURVEY MONUMENT RECORD

For Public Land Survey Corners in LIMA TWP. T. 4 N., R. 14 E.

CORNER CODE INDEX

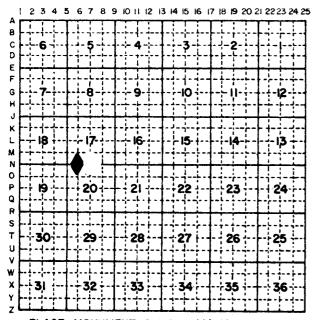

PLACE MONUMENT SYMBOL () AT PROPER LOCATION ON ABOVE INDEX


> IF AVAILABLE STATE PLANE COORDINATES

North (Y) 293,954,10 Eleve. (Z) 866


East (X)2,302,752,80 Zone South

Hor. Datum ____ Vert. Datum 1927

For Miscellaneous Corners within Sec. 17, T. 4 N., R. 14 E.

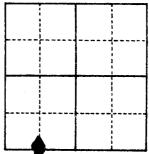


- Above code numbers are positioned Meander, Claim, or Fractional corners of the section.
- Township corner code numbers shall be applied to the corners of above typical section.

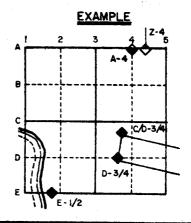

(a.)

CORNER MONUMENT

O WITNESS MONUMENT

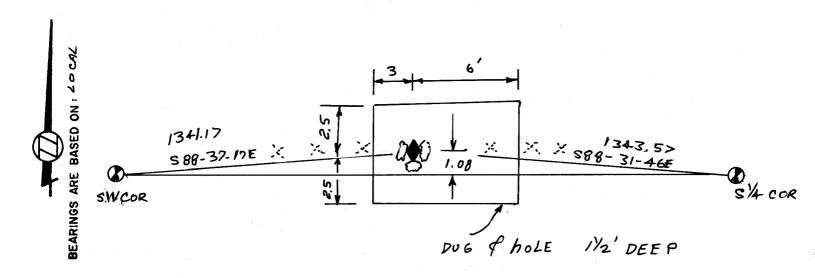

FIELD BOOK

SHOW A PLAN VIEW DRAWING DEPICTING THE CORNER MONUMENT AND SURROUNDING PHYSICAL FEATURES, INCLUDING THE EXCAVATION AREA AND DEPTH. THE CORNER MONUMENT SHALL HAVE THE FOLLOWING CHARACTERISTICS: 1) HAVE AT LEAST TWO PREDETERMINED BREAK-OFF POINTS. 2) IF BROKEN, LEAVE A PERMANENTLY MAGNETIZED REMNANT AT THE ORIGINAL POINT. 3) MUST BE EXTENDABLE. 4) THE CAP IS INSCRIBED : ROCK COUNTY SURVEY MONUMENT - PENALTY FOR DISTURBING MARKER. 5) OR AN EXISTING CUT LIMESTONE. AN IRON PIPE 1 2" x 4'0" (MINIMUM) MAY BE USED IN AREAS WHERE GROUND WATER IS WITHIN ONE FOOT OF THE SURFACE. IF THE CORNER IS OCCUPIED BY AN IMPROVEMENT (MANHOLE, BURIED CABLE, ETC.) ANY DURABLE, DISTINCT MONUMENT MAY BE USED. CORNERS SHALL BE REFERENCED WITH AT LEAST 4 DURABLE WITNESS MONUMENTS. WITNESS MONUMENTS SHALL BE MADE OF CONCRETE, NATURAL STONE, IRON OR OTHER EQUALLY DURABLE MATERIAL, EXCEPT WOOD. DESCRIBE THE CORNER AND THE WITNESS MONUMENTS. CORNER CODE: N6

(ъ.)	any other material evidence you con	ent evidence, occupational evidence, testimonial evidence or sidered, and whether the monument was found or placed. R. DID NOT FIND THE STAKE. BLEEDHORN SET THE COR.
	IN 1895 (VOL 2 FAGE: 492 COUNT	TY SURVEYOR'S RECORDS). THE STONES WERE IN HARMON
		TANCES. SET 3/8" X28" BOLT.
	· · · · · · · · · · · · · · · · · · ·	
(c.)	Was the corner restored through according found perpetuated location?	eptance of (1) an obliterated evidence location, or, (2) a
		en de la companya de La companya de la co
	ACCECTED CORNER AS FOUND.	
(d.)	Describe any material discrepancy b	etween the location of the corner as restored or
	by distance and direction. Show th	hat corner as previously restored or reestablished ediscrepancy on the plan view drawing under (0),
	above. Show the distances between and (1) the corner as restored or r monuments shown on the drawing in (the corner as previously restored or reestablished reestablished, and (2) to at least 4 of the witness
	monuments shown on the drawing in (
		graphic of the second of the s
	N A	

		المنظم المنظ المنظم المنظم
		en e
(e.)	Was the corner reestablished throumethod, including the directions a	igh lost corner proportionate methods? If so, show the and distances to other public land survey corners used as
	evidence or used for proportioning	in determining the corner location.
	$N_{\mathbf{A}}$	
	0.00	
	I, Nonald Barnes as identified by the co	, hereby certify that the corner points rner code index were, in a field survey on
		shed, re-established, monumented, re-monumente
	recovered or restored a	s expressed below and in conformance with the s required in the current manual of survey
	instructions of the Uni	ted States Department of Interior, Bureau
	of Land Management.	· · · · · · · · · · · · · · · · · · ·
		COUNTY SURVEYOR FILING DATA
		Date of Computer Entry
		Date Received
-		Date Microfilmed 10/15/1984
٠		Treasurer's Receipt No.
		Number of Included Sheets
		AFFIX YOUR LAND SURVEYOR SEAL. $N6$