
## U.S. PUBLIC LAND SURVEY MONUMENT RECORD

For Public Land Survey Corners in LIMA TWP. T. 4 N., R. 14E.

For Miscellaneous Corners within Sec. 32,T. 4 N., R. 14 E.

CORNER CODE INDEX

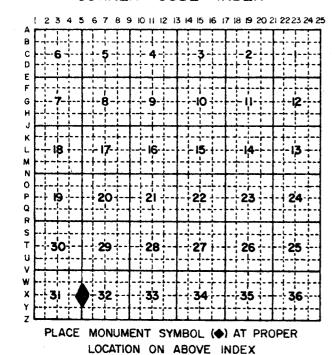

 Above code numbers are positioned Meander, Claim, or Fractional corners of the section.


 Township corner code numbers shall be applied to the corners of above typical section.

IF AVAILABLE
STATE PLANE COORDINATES

North (Y)280,712.75 Eleve. (Z) 890

East (X)2,301,532.38 Zone South


Hor. Datum Vert. Datum

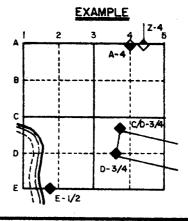

(a.)

CORNER MONUMENT

O WITNESS MONUMENT 3/g "X 28" IRON BOLTS

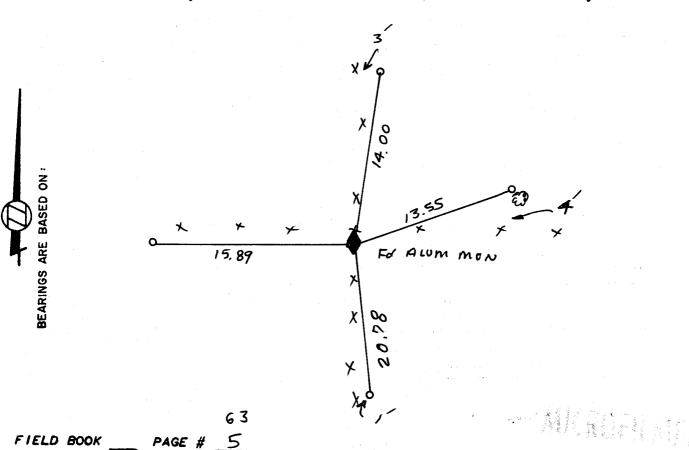

SHOW A PLAN VIEW DRAWING DEPICTING THE CORNER MONUMENT AND SURROUNDING PHYSICAL FEATURES, INCLUDING THE EXCAVATION AREA AND DEPTH. THE CORNER MONUMENT SHALL HAVE THE FOLLOWING CHARACTERISTICS: 1) HAVE AT LEAST TWO PREDETERMINED BREAK-OFF POINTS. 2) IF BROKEN, LEAVE A PERMANENTLY MAGNETIZED REMNANT AT THE ORIGINAL POINT. 3) MUST BE EXTENDABLE. 4) THE CAP IS INSCRIBED: ROCK COUNTY SURVEY MONUMENT - PENALTY FOR DISTURBING MARKER. 5) OR AN EXISTING CUT LIMESTONE. AN IRON PIPE 1/2" x 4'0" (MINIMUM) MAY BE USED IN AREAS WHERE GROUND WATER IS WITHIN ONE FOOT OF THE SURFACE. IF THE CORNER IS OCCUPIED BY AN IMPROVEMENT (MANHOLE, BURIED CABLE, ETC.) ANY DURABLE, DISTINCT MONUMENT MAY BE USED. CORNERS SHALL BE REFERENCED WITH AT LEAST 4 DURABLE WITNESS MONUMENTS. SHALL BE MADE OF CONCRETE, NATURAL STONE, IRON OR OTHER EQUALLY DURABLE MATERIAL, EXCEPT WOOD. DESCRIBE THE CORNER AND THE WITNESS MONUMENTS.

CORNER CODE: X-5(1)

(ъ.)	Describe any record evidence, monument evidence, occupational evidence, testimonial evidence of	or
	any other material evidence you considered, and whether the monument was found or placed.	

SUMMER OF 1982 FOUND LIMESTONE OF RECORD (16"X8"X4"). REPLACED WITH POLY MON. & SET CARSONITE.

(c.) Was the corner restored through acceptance of (1) an obliterated evidence location, or, (2) a found perpetuated location?

ACCEPTED FOUND PERPETUATED LOCATION.

(d.) Describe any material discrepancy between the location of the corner as restored or reestablished and the location of that corner as previously restored or reestablished by distance and direction. Show the discrepancy on the plan view drawing under (a), above. Show the distances between the corner as previously restored or reestablished and (1) the corner as restored or reestablished, and (2) to at least 4 of the witness monuments shown on the drawing in (a), above.

(e) Was the corner reestablished through lost corner proportionate methods? If so, show the method, including the directions and distances to other public land survey corners used as evidence or used for proportioning in determining the corner location.

I, Danie Barnes, hereby certify that the corner points as identified by the corner code index were, in a field survey on Apr. L 291963, established, re-established, monumented, re-monumented, recovered or restored as expressed below and in conformance with the regulations and rules as required in the current manual of survey instructions of the United States Department of Interior, Bureau of Land Management.



COUNTY SURVEYOR FILING DATA			
Date of Computer Entry			
Date Received			
Date Microfilmed 10/15/1984	_		
Treasurer's Receipt No.			
Number of Included Sheets			