U.S.


PUBLIC LAND SURVEY MONUMENT RECORD

For Public Land Survey Corners in:

WI ADMINISTRATIVE CODE A-E 7.08 REQUIREMENT

T.4N, R. /4 E

CORNER CODE INDEX

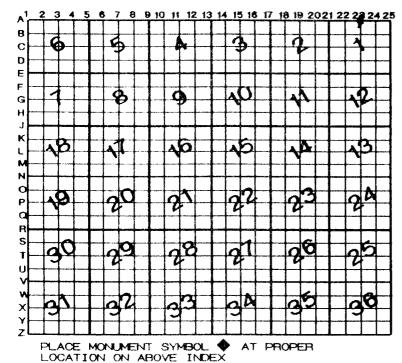

LIMA		TWP
ROCK	COUNTY	wı

IF AVAILABLE ROCK COUNTY COORDINATES PERFERRED

North ______ Elev. _____

East ______

Hor. Datum _____ Vert. Datum _____

LATITUDE _____ ELLIPS. HT.

LONGITUTE _____ ERLIPS. HT.

GPS (X) ____ TRAVERSE (X) ___

BASED ON THE FOLLOWING CONTROL:

♦ CORNER MONUMENT

WITNESS MONUMENT

BEAFINGS ARE BASED ON:

(a)

											1.
FIELD	BOOK	PAGE #						SHEET		OF	4_
SHOW	A PLAN VIEW	DRAWING	DEPICTING	THE CO	DRNER	MONUMENT	AND	SURRO	UNDING		
PHYSIC	AL FEATURES	INCLUDING	THE EYO	AVATION	ARFA	AND DEPT	н				

PLANNING & ZONING COMMITTEE ADOPTED THE ABOVE FORM ON 12/2/1982

LI512

(B) Describe any record evidence, monument evidence, occupational evidence, testimonial evidence or any other material evidence you considered, and whether the monument was found or placed.

- 1836 BRINK WEST ON SOUTH SIDE SEC 36 T5N R14E VAR 5-30E 380.82' BUR OAK 10 IN DIAMETER
 - 1188' ENTER MARSH @ NORTH
 - SET QUARTER SECTION POST BUR DAK 10 N68W 2640
 - 201.96' BUR OAK 14 S64W 233.64'
 - 2838' LEAVE MARSH @ NORTH
 - 5280 SET POST CORNER SECTIONS 35 & 36 BLACK DAK 18 N45E 34.32' & BUR DAK 16 N25W 43.56' LAND EXCEPT MARSH ROLLING SECOND RATE BUR, WHITE AND BLACK DAK, RED ROOT, MARSH GRASS, CANE GRASS, ETC.
- 1836 BURNHAM ORIG GOV SURVEYOR FOR LIMA TWP. DID NOT ESTABLISH N 1/4 COR SEC 1.
- ORIG GOV. PLAT DOES NOT SHOW A JOG AT N 1/4 COR SEC1
- 1857 CHURCH VOL 1 PG 74 STATES NOTHING ABOUT MONUMENT. 2642.64 TO NE & NW CORNERS OF SEC 1. USED TO SUBDIVIDE SEC 1.
- 1866 JONES -KOSH, REMONUMENTATION SURVEY MAP #6739 2638.68 TO SW COR SEC 36 & 2636.70 TO SE COR SEC 36.
 - FIELD NOTES WEST SOUTH SIDE SEC 36 VAR 4-10
 - 2636.70 FOUND STUMP TO ORIGINAL WITNESS TREE AND SET STONE 1/4 POST
 - SEC CORNER VERIFIED THE CORNER AND SET STONE COR TO SEC 35 7 36.

WEST SOUTH SIDE SEC 35 VAR 3-7

- 2643.96 QUARTER SEC POST FOUND STUMP N28E OTHER IN HIGHWAY. SET STONE 1/4 POST
- 5281.98 SECTION CORNER & SET STONE. THIS CORNER WAS PLACED IN THE CENTER OF A STRAIGHT LINE BETWEEN THE QUARTER POSTS OF SEC 34 & 35. NEW BEARING BLK OAK 10 S38 1/2E 53.13'

E 1/4 COR SEC 35 WAS DECLARED LOST & PLACED ON LINE BETWEEN THE NE & SE CORNERS OF SEC 35. 2626.80 TO SE COR SEC 35 & 2626.80 TO NE COR SEC 35.

- 1866 WOLLIN CORNER #5101 S 1/4 COR SEC 36 T5N R14E LAND CORNER RECORD STATES THE FOLLOWING: RESURVEY OF KOSHKONONG TWP, BY MILO JONES, AUGUST - DECEMBER 1886. FIELD NOTES SAY THAT BEARING TREE EVIDENCE WAS FOUND. FROM THIS EVIDENCE A LIMESTONE MONUMENT, APPROX. 6" BY 36" LONG WITH A SQUARE FINISHED TOP, WAS SET FOR THE CORNER. NOTES RECORDED IN THE REGISTER OF DEEDS, MISCELLANEOUS VOLUME 1, PAGES 389-412.
- 1963 BATTERMAN VOL 4 PG 167 5300.74 FROM NE COR SEC 1 TO NW COR SEC 1.
- BATTERMAN VOL 4 PG 167 DUG LARGE HOLE FD NOTHING FB #176 PG 5.
- 1974 WOLLIN CORNER #5101 S 1/4 COR SEC 36 T5N R14E LAND CORNER RECORD STATES THE FOLLOWING: DUG IN CORNER AREA WITH A BACKHOE, BUT DID NOT FIND THE STONE MONUMENT. I RE-ESTABLISHED THE CORNER ON THE TOWN LINE AND IN LINE WITH FENCE TO THE NORTH. AN IRON PIPE WAS SET FOR THE CORNER.
- 1979 WOLLIN VOL 5-554 NOTE: INFORMATION PROVIDED BY THOMAS WOLLIN, JEFFERSON COUNTY SURVEYOR. S 1/4 COR SEC 36 T5N R14E SET 1 1/4X24" I.P.. DUG ACROSS ROAD IN 1974 & FOUND NO EVIDENCE OF CORNER STONE. RESET CORNER IN A STRAIGHT LINE & IN LINE WITH FENCE TO THE NORTH. SKETCH SHOWS EXCAVATION HOLE STARTS ON SOUTH

SHEET 1 OF 4 CORNER CODE A-23()

Donald Barnes 2-26-03

SIDE OF PVMT. & EXTENDS NORTH OF NORTH SIDE OF PVMT. THE I.P. IS SHOWN ON THE NORTH SIDE OF THE PVMT. SKETCH CALLS FOR 2640.37 (ORIG 2640) TO AN ALUM MON AT THE SW COR SEC 36 AND 2649.60 (ORIG 2640.0) TO A 3" DIA PIPE AT THE SE COR SEC 36. NW COR SEC 1 IS AN IRON ROD 9.24' (ORIG 9.24') WEST OF THE SW COR SEC 36

- 1980 BARNES VOL 6 PG 64 NW COR SEC 1. FD IRON PIPE AT NW COR SEC 1. SET ALUM. FD ALUM AT SW COR SEC 36 T5N R14E. NW COR SEC 1 IS WEST 9.28'
- 1980 WOLLIN CORNER #5101 S 1/4 COR SEC 36 T5N R14E LAND CORNER RECORD STATES THE FOLLOWING: I REMOVED THE IRON PIPE AND SET AN ALUM. MAGNETIZED MONUMENT FOR THE CORNER. DRAWING SHOWS N 1/4 COR SEC 1 TO THE WEST OF S 1/4 COR SEC 36 AND THE FOLLOWING NOTE: GOV'T JOG= 4.62' PRO-RATED.
- 1982 BARNES A-23 @ S 1/4 COR SEC 36 FD 1 1/4" ALUM. PIPE WITH CAP. 17.0' NORTH OF CENTER OF PVMT. & 5.2 SE OF TELEPHONE PED. ELEV. 829 & NAD27 309,574.49 N/S; 2,325,365.78 E/W. LIMA FB #1 PG 47
- 1983 BARNES MAP #6747 REMONUMENTATION OF LIMA TOWNSHIP. N88-19-42W 2643.12 TO SW COR SEC 36 & S88-28-07E 2646.88.
- 1983 BARNES VOL 6 PG 308 THE N 1/4 COR SEC 2 AND THE NW COR SEC 1 WAS SET BY USING THE NW COR OF SEC 2 PRIOR TO THE FINDING OF THE CUT LIMESTONE. USING THE CUT LIMESTONE WILL DRASTICALLY MOVE THE BEFORE MENTIONED CORNERS. TOM WOLLIN, JEFFERSON COUNTY SURVEYOR, WILL DIG FOR THE S 1/4 COR OF SEC 36 T5N R14E. ONCE HE DOES THAT, I WILL RESET THE N 1/4 COR OF SEC 2 AND THE NW COR SEC 1.
- 1985 WOLLIN CORNER #5101 S 1/4 COR SEC 36 LAND CORNER RECORD STATES THE FOLLOWING: I FURTHER CHECKED FOR THE STONE MONUMENT BY DIGGING WITH A BACKHOE IN THE AREA OF THE TELEPHONE CABLES ON THE NORTH SIDE OF THE ROAD. I DID NOT FIND THE STONE MONUMENT. I RE-SET THE ALUMINUM MONUMENT WHERE IT HAD BEEN. A TELEPHONE CABLE RUNS ALONG SIDE OF 9IT, ABOUT 3' BELOW GROUND SURFACE.
- 1994 KREBS MAP #9602 SET 3/4X24" PIN 2.61' WEST OF S $\frac{1}{4}$ COR SEC 36 (FD ALUM.) 2649.61 TO NW COR SEC 1. ANGLE @ N $\frac{1}{4}$ COR SEC 1 FROM S $\frac{1}{4}$ COR SEC 1 TO NW COR SEC 1 88-00-29 & ANGLE AT NW COR SEC 1 FROM N $\frac{1}{4}$ COR SEC 1 TO W $\frac{1}{4}$ COR SEC 1 88-10-23
- 2002 BARNES ADJUSTMENT OF COMBINED TOWNSHIP

 REMONUMENTATION OBSERVATIONS. COORDINATES FOR N

 1/4 COR SEC 1 ON STRAIGHT LINE BETWEEN NE COR SEC 1 & SW

 COR SEC 36 AT A DISTANCE OF 2649.62 FROM NE COR SEC 1.

 USING THE COORDINATES THE FOLLOWING BEARINGS AND

 DISTANCES ARE:

NW SEC 1 TO N $\frac{1}{4}$ SEC 1 SBB-22-30E 2649.58 (KREBS 2649.61) N $\frac{1}{4}$ SEC 1 TO NE SEC 1 SBB-29-36E 2649.62 S $\frac{1}{4}$ SEC 36 TO N $\frac{1}{4}$ SEC 1 NBB-22-35W 2.65 (KREBS 2.61) ANGLE @ NW COR SEC 1 FROM N $\frac{1}{4}$ COR SEC 1 BB-10-32 (KREBS 8B-10-23)

2002 WOLLIN CORNER #5101 S 1/4 COR SEC 36 T5N R14E LAND CORNER RECORD STATES THE FOLLOWING: GPS COORDINATES ARE ASSIGNED. A TOPCON GP-SX1 SINGLE-FREQUENCY RECEIVER WAS USED. NAD1983(91) 309,582.758' N/S/; 2,293,828.041 E/W.

Parolo Banes 2-26-03

SHEET 2 OF 4 CORNER A-23(1)

LI512

I CONVERTED WOLLIN'S NAD83(91) COORDINATES TO THE FOLLOWING ROCK COUNTY COORDINATES:

SW COR SEC 36 N/S 327,650.529 E/W 553,874.225 S 1/4 COR SEC 36 N/S 327,575.55 E/W 556,516.087 SE COR SEC 36 N/S 327,506.072 E/W 559,162.135 THIS U.S. PUBLIC LAND SURVEY MONUMENT RECORD WAS IN RESPONSE TO QUESTIONS BY WIDOT DISTRICT 2 CONCERNING THE N 1/4 COR SEC 1. THIS RECORD SHOULD PUT THE FACTS IN EASIER AND UNDERSTANDABLE FORM.

C) Was the corner restored through acceptance of (1) an obliterated evidence location, or, (2) a found perpetuated location?

DID NOT ACCEPT NOR REJECT THE SET 3/4X24" PIN THAT KREBS PLACED IN 1994. THE PIN IS 2.61' WEST OF THE S $\frac{1}{4}$ COR SEC 36 (FD ALUM.)

D) Describe any material discrepancy between the location of the corner as restored or reestablished and the location of that corner as previously restored or reestablished by distance and direction. Show the discrepancy on the plan view drawing under (a), above. Show the distances between the corner as previously restored or reestablished and (1) the corner as restored or reestablished, and (2) to at least 4 of the witness monuments shown on the drawing in (a), above.

AS STATED IN 1983 BARNES VOL 6 PG 308, THE NW COR OF SEC 1 WAS ESTABLISHED BY USING THE ERRONEOUS N ¼ CORNER OF SEC 2. TOM WOLLIN, JEFFERSON COUNTY SURVEYOR. IN 1985, THE JEFFERSON COUNTY SURVEYOR, WOLLIN REDUG FOR THE S ¼ COR OF SEC 36 T5N R14E. HE DID NOT FIND THE STONE & ACCEPTED HIS PREVIOUS POSITION FOR THE S ¼ COR SEC 36. SINCE THE N ¼ COR OF SEC 1 NEEDS TO BE SET MIDWAY BETWEEN THE NW AND NE CORNERS OF SEC 1, I DID NOT ESTABLISHED THE CORNER BECAUSE THE NW COR SEC 1 WAS ESTABLISHED USING THE ERRONEOUS N ¼ COR SEC 2. IN 1994 KREBS MAP #9602 SET FOR THE N ¼ COR SEC 1 A 3/4X24" PIN 2.61' WEST OF S ¼ COR SEC 36 (FD ALUM.) HIS DISTANCE TO THE NW COR OF SEC 1 INDICATES HE INTENDED TO PLACE THE CORNER MIDWAY BETWEEN THE NW & NE CORNERS OF SEC 1.

THE DEPUTY VISITED THE SITES ON 2/11/03 AND REPORTED THAT THE TERRAIN WAS SUCH THAT AT THE S 1/4 COR SEC 36 THERE WAS A HIGH PROBABILITY THAT THE CUT L.S. SHOULD BE THERE. IN THIS AREA THE ROAD IS IN A FILL AREA. AFTER REVIEWING THE RECORD DISTANCES FROM THE NE COR SEC 1 TO THE CUT L.S. AT THE S 1/4 COR SEC 35, I BELIEVE IT IS POSSIBLE THE STONE MAY BE JUST EAST OF THE PREVIOUS EXCAVATIONS AND IN THE PAVEMENT AREA OR NORTH OF THE PAVEMENT. AT THE SW COR SEC 36, HE REPORTED 3 OF THE 4 SIDES OF THE INTERSECTION WERE HIGHER WITH THE SE INTERSECTION BEING SUBSTANTIALLY LOWER. MORE THAN LIKELY THE ROAD CUT DESTROYED THE CUT L.S.

(E) Was the corner reestablished through lost corner proportionate methods? If so, show the method, including the directions and distances to other public land survey corners used as evidence or used for proportioning the corner location.

I, **Donald Barnes**, hereby certify that the corner location as identified by the corner code index was determined by me under my direction and control and that this U.S. Public Land Survey Monument Record is correct and complete to the best of my knowledge and belief.

Finition

SHEET 3 OF 4

CORNER CODE A-23(1)

2-26-03

A.E. 7.08 REQUIREMENT

3S7,506,00'N/S 559,162,19'E/W S003 BARNES READJUSTMENT S003 BYBNEZ NO-00-05E
1883 BYBNEZ KEWON NO-11-03E
1823 CHOKCH 1-34 5974,55 2974,55 2974,55 \$1,506,07V\7 VOLLIN TO ROCK 5YS. 2003 BARNES CONV. OF סאופ 13 BARNES READJUSTMENT (531,97 N/S 309,542,817'N/5, 2,296,474,538 E/W S005 MOLLIN GPS CORNER #4901 | VOLLIN 2655,47 ES READJUSTMENT S88-29-36E 2649 S88-29-36E 2649 JES S88-29-36E 2 VDLLIN 5-554 2 10N. S88-28-07E 6 6 JONES REMON, 2 SEC 2646.10 MEASURED 7,928.98' NES REMON. 7,919.34 DIFF 9,64 CHURCH WOLLIN 3 닏 1963 BATTERMAN BARNES READJUST 1979 SS6,516.14' 2002 BARNES SEC 2 TO REMON. S003 BARNES READJUSTMENT 띪 1/4 E\M 5003 BARNES N88-22-35W 2.65 209,574,49N/S 1982 BARNES NAD27 2643.12 2640.37 2638.68 2640 S003 BARNES READJUSTMENT 327,575,674/5, 556,513,49 E/W 327,650.53'N/5, 553,874,24'E/\#. 1994 KREBS #9602 2:61
2002 BARNES COMBINED TWP ADJ. 2564.189
88-22-31V 264.2 REMON 6 BRINK 1 REMDN, N88-19-42W 1979 WOLLIN 5-554 1866 JONES REMDN. 2604,92 WDLLIN 2645.88 REMDN 2626.80' WOLLIN : 35,7,650,53,4/5,552,6,700,3 BARNES CONV. OF 2003 BARNES CONV. OF 2009,628.240 N/S) 2,291,185,665' 2009, WOLLIN GPS CORNER #5301 \$57,650.53'N/\$1553,874.24E/V 327,650.53'N/\$1553,874.24E/V 2002 જુ DOMES REMON, S62,807 180-00 178-18-14 1977 WOLLIN 2639.08
BARNES S88-21-18E 2639.06
REMON S88-19-56E 2639.03
1886 KOSH REMON 2643.96 09-53E 3012,58 0 4-187 3012,58 081G 2983,20 1937 VOLLIN 2623,28 1983 BARNES REMON 4-187 3012.58 2003 BATTERMAN 4-187 3012.58 2003 BATTERMAN 4-187 3012.58 1980 BARNES 6-64 9.28 2630.88 1836 BURNHEM 9.24 \$503 BARNES READJUSTMENT 327,650,80°4/5, 553,864,97E/V JONES REMON. 1977 VOLLIN BARNES 5-259 IES S88-21-15E 1977 2647.18 PROJECTION BARNES COUNTY 2003 B BARNES 1977 R13 357,726,29N/S1 551,236,28E/W 1985 MOLLIN ALUM. S S003 BARNES READJUSTMENT S003 BARNES READJUSTMENT 327,726,26N/S, 551,239,17E/W ŏ 85,855,128 (2\N'65,857,755 \$003 BARNES \$89-17-17E \$.90
\$003 BARNES \$60-17-17E \$.90
\$003 BARNES \$60-17-17E \$.90 READJUSTMENT 14 357,726,32'4/5, 551,235.22'7 1510LI ERRONEOUS MON. 5101.1 H | S005 WOLLIN GPS CORNER #5101 | S002 CUT L.S. 2640,60 2640,55 2638,02 INDICATES THE READJU TOWNSHIP USING SOME COORDINATES ALONG 2647,70 2630.88 2626,90 1977 BARNES 5-259 1.05 S S88-02-36E KDSH, REMDN, 5-259 BARNES BARNES S REMON 1886 KI BARNES 1977 BAR BARNES 2003 BARN OF ALL TH VOLLIN'S (LINE 2003 \$005 MOLLIN GPS CORNER #5101 NAD83(91) 309,735,309'N/S, 2,285,907.593 E/W 2003 SOOS MOLLIN C.I, \$2003 BARNES \$288-03-19E 16.59
\$2003 BARNES COUV. OF FD CUT L.5
\$2002 WOLLIN TO ROCK \$75.
\$2002 WOLLIN TO ROCK \$75.
\$2002 WOLLIN TO ROCK \$75.
\$2003 BARNES \$75.
\$2004 BARNES \$75.
\$2005 BARNES \$ 185 1983 BARNES REMUN NO-37-54E 3019.00 3020,41 3013,9 3003,00

Dord Banes 7-16-03

A-23(1)