U.S.


PUBLIC LAND SURVEY MONUMENT RECORD

For Public Land Survey Corners in:

WI ADMINISTRATIVE CODE A-E 7.08 REQUIREMENT

T.4N. R. 14 E

CORNER CODE INDEX

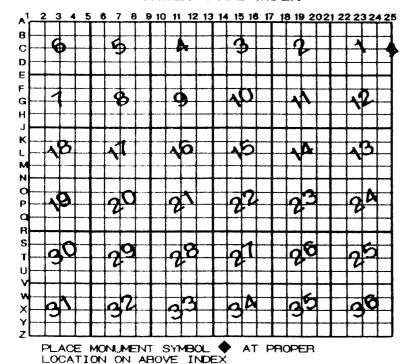

LIMA ROCK COUNTY WI

IF AVAILABLE ROCK COUNTY COORDINATES PERFERRED

North Elev.

Fast

Hor. Datum _____ Vert. Datum

LATITUDE ____ ELLIPS. HT. LONGITUTE

GPS (X) TRAVERSE (X) _

BASED ON THE FOLLOWING CONTROL:

CORNER MONUMENT

O WITNESS MONUMENT

(a)

SHEET 4.3

PI 36+44,495 [SHEET # 125]

INFORMATION IS FROM WIDOT DISTRICT 2 R/W PLAT - PROJECT 1080-00-22, DATED 11-26-1997 & LAST REVISION DATE OF 8-7-2001.

"THIS PLAT HAS GROUND COORDINATES THAT ARE ADJUSTED TO GPS POINTS WHITEWATER AND ELKHORN USING GPS TECHNOLOGY.

"COORDINATES ON THIS PLAN ARE REFERENCED TO THE WISCONSIN STATE PLANE COORDINATE SYSTEM (WSPCS), 'SOUTH' ZONE" NAD83(91)

"TO CONVERT GROUND COORDINATE (N & E) TO GRID COORDINATES (X & Y) MULTIPLY GROUND (N & E) BY FACTOR 0.9999441 AND ADD 2,000,000 TO THE X COORDINATE." **ELEVATIONS ARE BASED ON NGVD29**

NOTE: THE COORDINATES ARE NOT BASED ON THE ROCK COUNTY PROJECTION. BY USING THE GIS I DETERMINED THEY ARE PROBABLY NOT WALWORTH, DANE, OR JEFFERSON COUNTY PROJECTIONS, BUT I COULD NOT FIND ANY CALL ON THE MAPS.

CONC. MON / BRASS CAP N= 306, 585.61

Donal Fanes 6-25-03

E= 296,516,55

N 08-15-43E 2805.41 TO CENTER SPC 6 TAN N 0-29-21 W 2974,54 TO NE / SHEET / OF /

SHOW A PLAN VIEW DRAWING DEPICTING THE CORNER MONUMENT AND SURROUNDING PHYSICAL FEATURES, INCLUDING THE EXCAVATION AREA AND DEPTH.

PLANNING & ZONING COMMITTEE ADOPTED THE ABOVE FORM ON 12/2/1982

CORNER CODE $C \cdot 25(z)$