


# U.S. PUBLIC LAND SURVEY MONUMENT RECORD

LIMA For Public Land Survey Corners in the  
T. 4 N., R. 14 E.

For Miscellaneous Corners within Sec.  
25, T. 4 N., R. 14 E.


## CORNER CODE INDEX

	1	2	3	4	5	6	7	8	9	10	11	12	13	14	15	16	17	18	19	20	21	22	23	24	25
A																									
B																									
C	6																								
D																									
E																									
F																									
G	7																								
H																									
J																									
K																									
L	18																								
M																									
N																									
O																									
P	19																								
Q																									
R																									
S																									
T	30																								
U																									
V																									
W																									
X																									
Y	31																								
Z																									

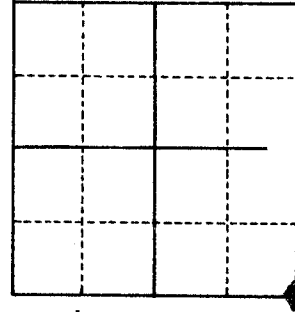

1. Above code numbers are positioned Meander, Claim, or Fractional corners of the section.
2. Township corner code numbers shall be applied to the corners of above typical section.


### EXAMPLE

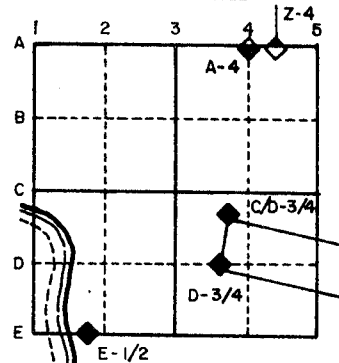

PLACE MONUMENT SYMBOL (◆) AT PROPER LOCATION ON ABOVE INDEX

IF AVAILABLE  
STATE PLANE COORDINATES

North (Y) 285,404.15 Eleve. (Z) \_\_\_\_\_  
 East (X) 2,327,992.93 Zone SOUTH  
 Hor. Datum \_\_\_\_\_ Vert. Datum \_\_\_\_\_

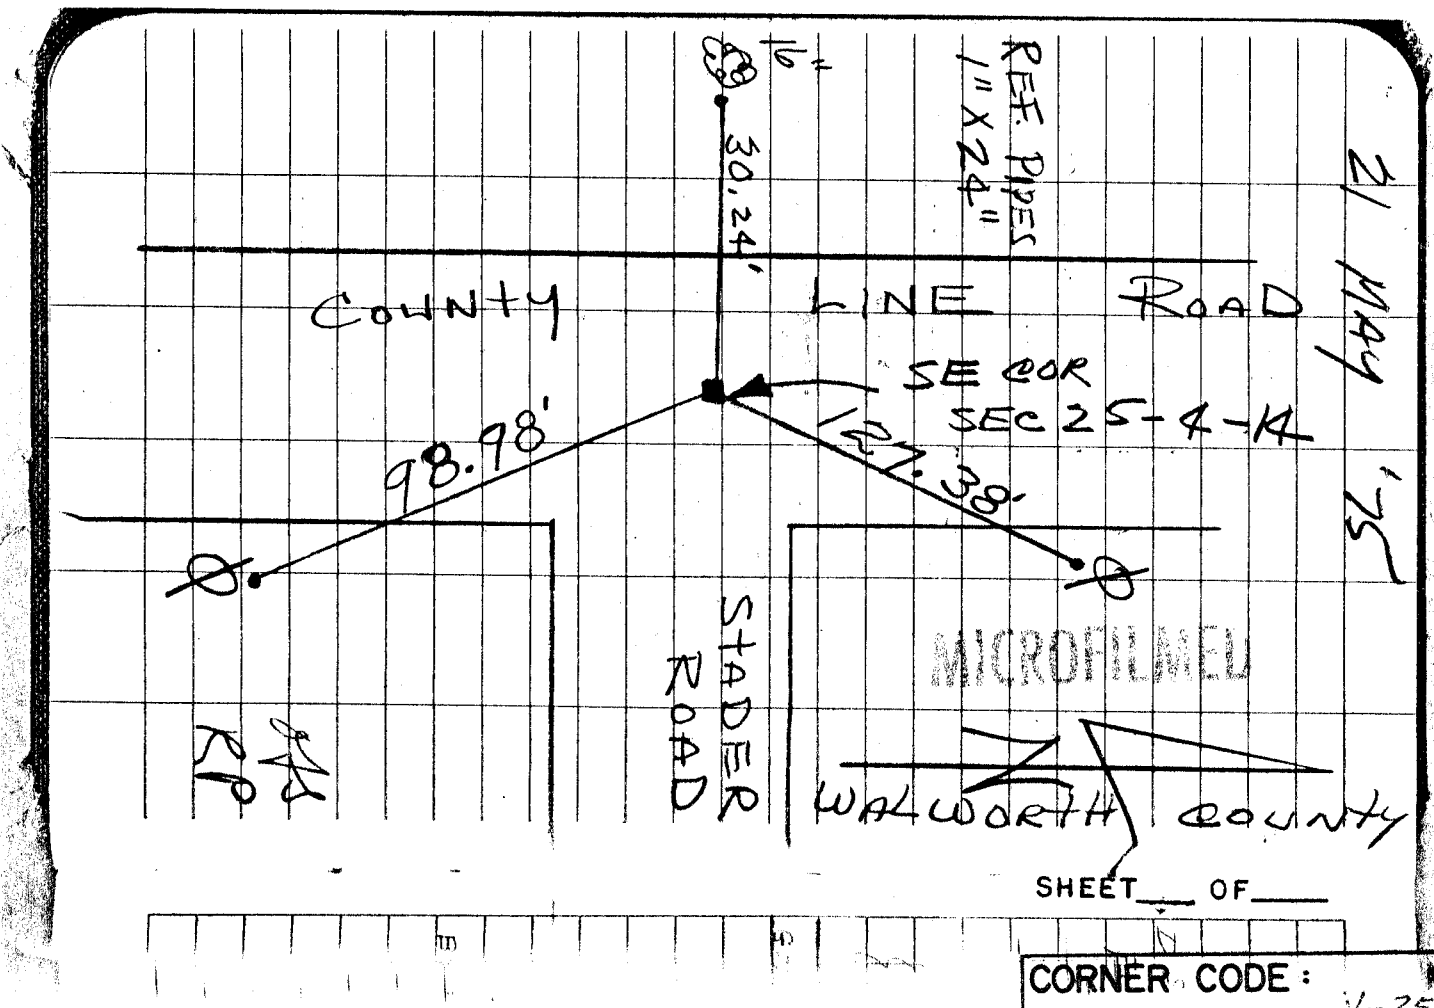

SHEET \_\_\_\_\_ OF \_\_\_\_\_

CORNER CODE: V-25 (11) 25

