
## U.S. **PUBLIC** LAND SURVEY MONUMENT RECORD

For Public Land Survey Corners in the T. 4 N., R. 14 E.

## CORNER CODE INDEX

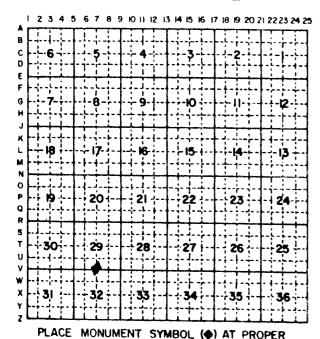

LOCATION ON ABOVE INDEX

ROCK COUNTY

IF AVAILABLE STATE PLANE COORDINATES

1/2

North	( X )	Eleve. (Z)
East		Zone
Hor.	Datum	Vert. Datum

( a.)	(	a.	)
-------	---	----	---

CORNER MONUMENT

O WITNESS MONUMENT

	•
$\mathfrak{P}$	RASED
+	APF
	RFARINGS

FIELD BOOK PAG	SE #
----------------	------

SHOW A PLAN VIEW DRAWING DEPICTING THE CORNER MONUMENT AND SURROUNDING PHYSICAL FEATURES, INCLUDING THE EXCAVATION AND DEPTH. THE CORNER MONUMENT SHALL HAVE THE FOLLOWING CHARACTERISTICS: I) HAVE AT LEAST TWO PREDETERMINED BREAK-OFF POINTS. 2) IF BROKEN, LEAVE A PERMANENTLY MAGNETIZED REMNANT AT THE ORIGINAL POINT. 3) MUST BE EXTENDABLE. 4) THE CAP IS INSCRIBED ROCK COUNTY SURVEY MONUMENT - PENALTY FOR DISTURBING MARKER. 5) OR AN EXISTING CUT LIMESTONE. AN IRON PIPE 1 2 1 4'0" (MINIMUM) MAY BE USED IN AREAS WHERE GROUND WATER IS WITHIN ONE FOOT OF THE SURFACE. IF THE CORNER IS OCCUPIED BY AN IMPROVEMENT (MANHOLE, BURIED CABLE, ETC.) ANY DURABLE, DISTINCT MONUMENT MAY BE USED. CORNERS SHALL BE REFERENCED WITH AT LEAST 4 DURABLE WITNESS MONUMENTS. WITNESS MONUMENTS SHALL BE MADE OF CONCRETE, NATURAL STONE, IRON OR OTHER EQUALLY DURABLE MATERIAL, EXCEPT WOOD. DESCRIBE THE CORNER AND THE WITNESS MONUMENTS.

CORNER CODE:

V7(Z)

- Describe any record evidence, monument evidence, occupational evidence, testimonial evidence or any other material evidence you considered, and whether the monument was found or placed.
- 1973 LEE VOL 5 PG 25 DOES NOT DESCRIBE MONUMENT. PLACED TIES AND CALLED FOR MONUMENT SOUTH OF CENTER PAVEMENT, 10 EAST OF N/S FENCE ON NORTH SIDE OF ROAD
- 1982 BARNES V7 FOUND OLD REFERENCE MONUMENTS. PLACED PK FROM TIES. PK WAS 8.3 SOUTH OF CENTER PVMT.
- 1982 BARNES TOWNSHIP PROJECT. FOUND DOT PI STATIONS 216+38.86 & 253+84.14. OCCUPIED 253+84.14 AND USED 216+38.86 AS THE BACKSIGHT. MEASURED ANGLE AND DISTANCE TO S 1/4 CORNER OF SECTION 29. LEAST SQUARES COORDINATE TRANSFORMATION PROGRAM AND COMPUTED 283,364.37; 2,301,452.14. CALLED FOR 2648.27 TO SW 29 AND 2649.33 TO SE CORNER OF SECTION 29.
- 198? DOT V7(1) FOUND 1/2 SCREW & RIBBON. 8.34 TO REF LINE (RT) 273+77.58.
- 1983 DOT R/W MAP PK NAIL, 283,314.53; 2,304,099.63.

PLACED SMALL R/R SPIKE.

C) Was the corner restored through acceptance of (1) an obliterated evidence location, or, (2) a found perpetuated location?

ACCEPTED OBLITERATED EVIDENCE LOCATION. USED RECORD DISTANCE TO THE NW REFERENCE TIE, DOT REFERENCE LINE INFORMATION, NEW AND OLD TWP TRAVERSE BETWEEN THE SW LINE OF SECTION 31 AND STATIONS NEAR THE SE CORNER OF SECTION 29 TO COMPUTE THE POSITION BY LEAST SQUARES.

- Describe any material discrepancy between the location of the corner as restored or reestablished and the location of that corner as previously restored or reestablished by distance and direction. Show the discrepancy on the plan view drawing under (a), above. Show the distances between the corner as previously restored or reestablished and (1) the corner as restored or reestablished, and (2) to at least 4 of the witness monuments shown on the drawing in (a), above.
- Was the corner reestablished through lost corner proportionate methods? If so, show the method, including the directions and distances to other public land survey corners used as evidence or used for proportioning the corner location.

I, Donald Barnes, hereby certify that the corner points as identified by the corner code index were, in a field survey on, November 9, 1992, established, re-established, monumented, re-monumented, recovered or restored as expressed below and in conformance with the regulations and rules as required in the current manual of survey instructions of the United States Department of Interior, Bureau of Land Management.

40360260600000

COUNTY SURVEYOR FILING DATA

Date of computer entry


Date microfilmed


Number of included sheets

CORNER CODE

AFFIX YOUR LAND SURVEYOR SEAL



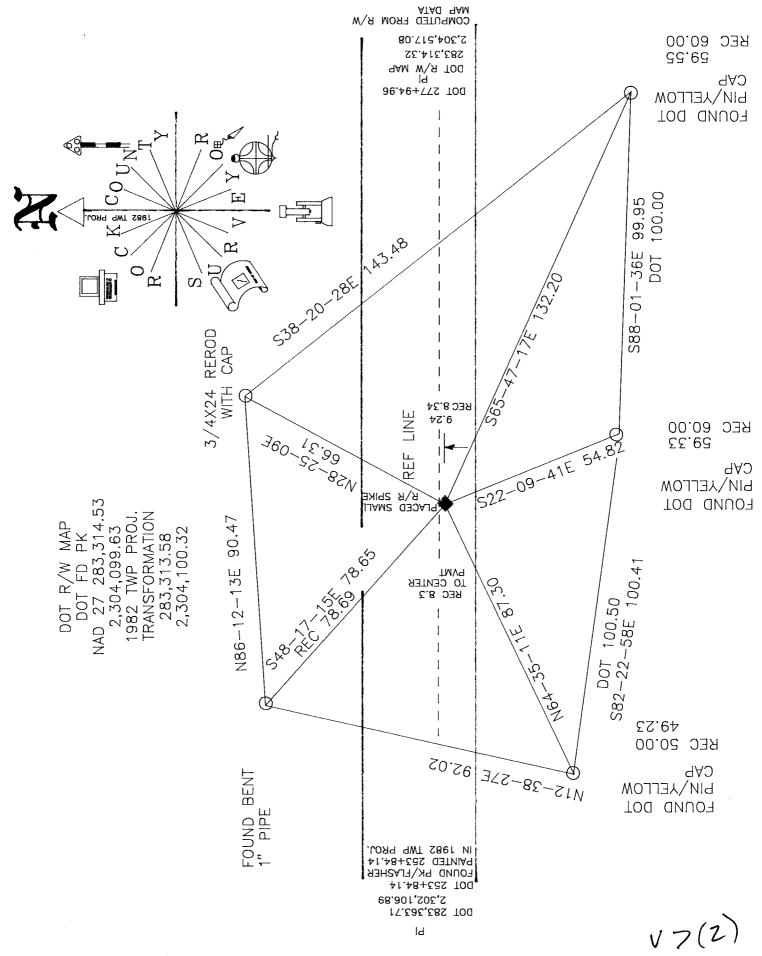

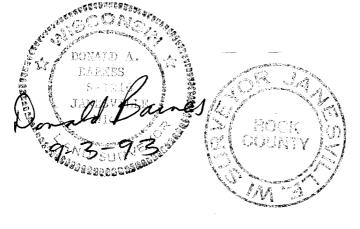

DOT 180-09-53.5 180-12-44 DOT 180-20-24 180-20-52	DOT 180-05-04 180-04-23
--	----------------------------

REFERENCE LINE CO 1982 TWP PROJECT R/W MAP, & NEW F	DATA, DOT
INV S	A 1938.86 TATE 1938.77 7-58E 1938.86
DOT 196+99.98 PI FD PK	

DOT 283,325.18

STA 1938.86 INV STATE 1938.77 S89-57-58E 1938.86	STA 1858 INV STATE 18 S89-4514E	358.74 INV STATE 1886.38	INV STAT	2593.62 E 2593.48 51E 2593.60
19 20 74	DOT 216+38.84 PI FD PK	DOT 234+97.67 Pl	DOT 277+94.96 Pl	DOT 303+88.58 PI FD PK
2,296,423.17 NAD 27 R/W PLAT	DOT 283,345.82 2,298,361.83 NAD 27 R/W PLAT	DOT 283,360.26 2,300,220.51 NAD 27 R/W PLAT	DOT 283,314.32 2,304,517.08 NAD 27 R/W PLAT	DOT 283,257.37 2,307,109.94 NAD 27 R/W PLAT

## 1982 TWP PROJECT

