U.S.

(a)

Ż


## PUBLIC LAND SURVEY MONUMENT RECORD

For Public Land Survey Corners in:

WI ADMINISTRATIVE CODE A-E 7.08 REQUIREMENT

T.4N., R. 10E

CORNER CODE INDEX

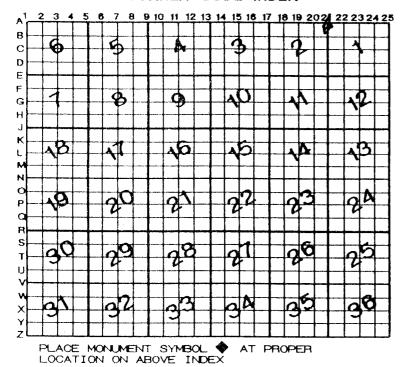

LIM	A	TWI
ROCK	COUNTY	WI

IF AVAILABLE
ROCK COUNTY COORDINATES PERFERRED

---- Elev.

East \_\_\_\_\_

Hor. Datum \_\_\_\_\_ Vert. Datum \_\_\_\_

LATITUDE \_\_\_\_\_ELLIPS. HT

GPS (X) \_\_\_ TRAVERSE (X) \_\_\_

BASED ON THE FOLLOWING CONTROL:

♦ CORNER MONUMENT

O WITNESS MONUMENT

North \_\_\_\_

LONGITUTE

SHEET 164 ALUM MON CSE COR SEC35 TJN R/4E N= 309, 645,5/ E=291, 202,93

INFORMATION IS FROM WIDOT DISTRICT 2 R/W PLAT - PROJECT 1080-00-22, DATED 11-26-1997 & LAST REVISION DATE OF 8-7-2001.

"THIS PLAT HAS GROUND COORDINATES THAT ARE ADJUSTED TO GPS POINTS WHITEWATER AND ELKHORN USING GPS TECHNOLOGY.

"COORDINATES ON THIS PLAN ARE REFERENCED TO THE WISCONSIN STATE PLANE COORDINATE SYSTEM (WSPCS), 'SOUTH' ZONE" NADB3(91)

"TO CONVERT GROUND COORDINATE (N & E) TO GRID COORDINATES (X & Y) MULTIPLY GROUND (N & E) BY FACTOR 0.9999441 AND ADD 2,000,000 TO THE X COORDINATE." ELEVATIONS ARE BASED ON NGVD29

NOTE: THE COORDINATES ARE NOT BASED ON THE ROCK COUNTY PROJECTION. BY USING THE GIS I DETERMINED THEY ARE PROBABLY NOT WALWORTH, DANE, OR JEFFERSON COUNTY PROJECTIONS, BUT I COULD NOT FIND ANY CALL ON THE MAPS.

Dord Bars

FIELD BOOK \_\_\_\_\_PAGE # \_\_\_\_

SHEET \_\_\_\_\_ OF \_\_\_\_

SHOW A PLAN VIEW DRAWING DEPICTING THE CORNER MONUMENT AND SURROUNDING PHYSICAL FEATURES, INCLUDING THE EXCAVATION AREA AND DEPTH.

PLANNING & ZONING COMMITTEE ADOPTED THE ABOVE FORM ON 12/2/1982