
PUBLIC LAND SURVEY U.S. MONUMENT RECORD

For Public Land Survey Corners in: TAN, R. HE

WI ADMINISTRATIVE CODE A-E 7.08 REQUIREMENT

CORNER CODE INDEX

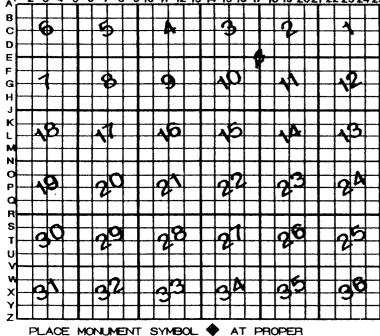

111	TWP		
ROCK	COUNTY	WI	

IF AVAILABLE ROCK COUNTY COORDINATES PERFERRED

North _____ Elev. Hor. Datum _____ Vert. Datum LATITUDE _____ ___ ELLIPS. HT. LONGITUTE __ GPS (X) ___ TRAVERSE (X) ___ BASED ON THE FOLLOWING CONTROL:

CORNER MONUME	14 1	

LOCATION ON ABOVE INDEX

WITNESS MONUMENT

ö BASED BEARINGS ARE

(a)

						,	
FIFI D	BOOK	PAGE #			SHEET	_ OF	2
		DRAWING DEPICTING		MONUMENT	AND SURROUND	DING	
PHYSIC	AL FEATURES	INCLUDING THE EYO	VATION AREA	AND DEDT	u		

PLANNING & ZONING COMMITTEE ADOPTED THE ABOVE FORM ON 12/2/1982

LI529

(B)Describe any record evidence, monument evidence, occupational evidence, testimonial evidence or any other material evidence you considered, and whether the monument was found or placed.

1982 BARNES VOL 6 PG 248 FOUND ALUMINUM MON. WITH TOP BROKEN OFF. SET 3/2X32 BOLT AS REFERENCE MONUMENTS. REFERENCE: VOL 5 PG 262 FIELD BOOK LIMA PAGE 44.

FD ALUM. WITH TOP BROKE OFF & 3 REFERENCE BOLTS. MONUMENT MAY BE DISTURBED BY ROAD CONSTRUCTION.

C) Was the corner restored through acceptance of (1) an obliterated evidence location, or, (2) a found perpetuated location?

ACCEPTED FOUND PERPETUATED LOCATION.

- D) Describe any material discrepancy between the location of the corner as restored or reestablished and the location of that corner as previously restored or reestablished by distance and direction. Show the discrepancy on the plan view drawing under (a), above. Show the distances between the corner as previously restored or reestablished and (1) the corner as restored or reestablished, and (2) to at least 4 of the witness monuments shown on the drawing in (a), above.
- (E) Was the corner reestablished through lost corner proportionate methods? If so, show the method, including the directions and distances to other public land survey corners used as evidence or used for proportioning the corner location.

I, Donald Barnes, hereby certify that the corner location as identified by the corner code index was determined by me under my direction and control and that this U.S. Public Land Survey Monument Record is correct and complete to the best of my knowledge and belief.

Word Baines
May 28 1999

Number of included sheets 1

CORNER CODE E-17(1)

