
PUBLIC LAND SURVEY U.S. MONUMENT RECORD

For Public Land Survey Corners in:

WI ADMINISTRATIVE CODE A-E 7.08 REQUIREMENT

T. 4N., R. 14 E

CORNER CODE INDEX

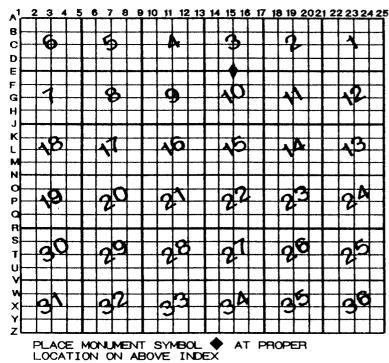

UMA		TWF
ROCK	COUNTY	WI

IF AVAILABLE ROCK COUNTY COORDINATES PERFERRED

Elev. East Hor. Datum _____ Vert. Datum LATITUDE _____ __ ELLIPS. HT. LONGITUTE __ GPS (X) ___ TRAVERSE (X) ___ BASED ON THE FOLLOWING CONTROL:

CORNER	MONUMENT
--------	----------

WITNESS MONUMENT

ÿ O BASED BEARINGS ARE

(a)

		,	7
FIELD BOOKPAGE #	SHEET _	OF	
SHOW A PLAN VIEW DRAWING DEPICTING THE CORNER MONUMENT AND	SURROUN	1DING	
PHYSICAL FEATURES, INCLUDING THE EXCAVATION AREA AND DEPTH.			
PLANNING & ZONING COMMITTEE ADOPTED THE ABOVE FORM ON 12/2/1982			

LI528

(B)Describe any record evidence, monument evidence, occupational evidence, testimonial evidence or any other material evidence you considered, and whether the monument was found or placed.

1982 BARNES VOL 6 PG 248 FOUND ALUM. MON. REFERENCE VOL 5 PG 545 FIELD **BOOK LIMA PAGE 44.**

1982 BARNES E-15 FOUND ALUM. & REFERENCE MONUMENTS.

FOUND ALUM. MON. & 3 REFERENCE TIES. CORNER MAY BE DISTURBED. BY Road CONSTRUCTION

C) Was the corner restored through acceptance of (1) an obliterated evidence location, or, (2) a found perpetuated location?

ACCEPTED ALUM.

- D) Describe any material discrepancy between the location of the corner as restored or reestablished and the location of that corner as previously restored or reestablished by distance and direction. Show the discrepancy on the plan view drawing under (a), above. Show the distances between the corner as previously restored or reestablished and (1) the corner as restored or reestablished, and (2) to at least 4 of the witness monuments shown on the drawing in (a), above.
- (E) Was the corner reestablished through lost corner proportionate methods? If so, show the method, including the directions and distances to other public land survey corners used as evidence or used for proportioning the corner location.

I, Donald Barnes, hereby certify that the corner location as identified by the corner code index was determined by me under my direction and control and that this U.S. Public Land Survey Monument Record is correct and complete to the best of my knowledge and belief.

Donald Baines May 28 1999

Number of included sheets 1

CORNER CODE E-15(1)

