

# U.S. PUBLIC LAND SURVEY MONUMENT RECORD

For Public Land Survey Corners in:

WI ADMINISTRATIVE CODE A-E 7.08 REQUIREMENT

T. / N., R. / DE

### CORNER CODE INDEX

A	2	3	4	5	6	7	8	9	10	11	12	13	14	15	16	17	18	19	20	21	22	23	24	25
B																								
C	6																							
D																								
E																								
F	1																							
G																								
H																								
J																								
K	18																							
L																								
M																								
N																								
O																								
P	19																							
Q																								
R																								
S																								
T	30																							
U																								
V																								
W																								
X	31																							
Y																								
Z																								

AVON TWP  
ROCK COUNTY WI

IF AVAILABLE  
ROCK COUNTY COORDINATES PREFERRED

North \_\_\_\_\_ Elev. \_\_\_\_\_

East \_\_\_\_\_

Hor. Datum \_\_\_\_\_ Vert. Datum \_\_\_\_\_

LATITUDE \_\_\_\_\_ ELLIPS. HT. \_\_\_\_\_

LONGITUDE \_\_\_\_\_

GPS (X) \_\_\_\_\_ TRAVERSE (X) \_\_\_\_\_

BASED ON THE FOLLOWING CONTROL:

PLACE MONUMENT SYMBOL  $\blacklozenge$  AT PROPER LOCATION ON ABOVE INDEX

$\blacklozenge$  CORNER MONUMENT


$\circ$  WITNESS MONUMENT

(a)

1871 RUGER DROVE STAKE DEEP & PUT ON TOP OF IT SANDSTONE 1A X 7 X 6 @ WITH 4 SANDSTONES

1939 SUNNY Fd 7X4X12 SANDSTONE OVER HOLE WITH DECAYED STAKE IN IT. SET 2" X 40" PIPE FOR MON. REF. TO 2 TREES

BEARINGS ARE BASED ON:

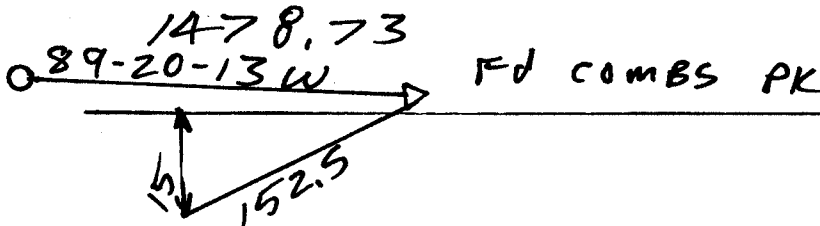

7-02-03  
Donald Barnes

SEARCHED WITH METAL LOCATOR & Fd NOTING. PIPE WAS PROBABLY DITCHED OUT.

FIELD BOOK OBSERVATION SHEET 202 PAGE # \_\_\_\_\_

SHEET 1 OF 1

SHOW A PLAN VIEW DRAWING DEPICTING THE CORNER MONUMENT AND SURROUNDING PHYSICAL FEATURES, INCLUDING THE EXCAVATION AREA AND DEPTH.

PLANNING & ZONING COMMITTEE ADOPTED THE ABOVE FORM ON 12/2/1982

CORNER CODE G-22 (1)