

U.S. PUBLIC LAND SURVEY MONUMENT RECORD

For Public Land Survey Corners In:
T. N. R. 10 E. 4th P.M.
CORNER CODE INDEX

WI ADMINISTRATIVE CODE A-E 7.08 REQUIREMENT
REV 10/23/2004 USMONREC.DWG

 AVON TWP
ROCK COUNTY WI

IF AVAILABLE
ROCK COUNTY COORDINATES PREFERRED

A	1	2	3	4	5	6	7	8	9	10	11	12	13	14	15	16	17	18	19	20	21	22	23	24	25	A
B						6																				B
C							5																			C
D																										D
E																										E
F																										F
G																										G
H																										H
J																										J
K																										K
L																										L
M																										M
N																										N
O																										O
P																										P
Q																										Q
R																										R
S																										S
T																										T
U																										U
V																										V
W																										W
X																										X
Y																										Y
Z																										Z

PLACE MONUMENT SYMBOL AT PROPER LOCATION ON ABOVE INDEX

North _____ Elev. _____

East _____

Hor. Datum _____ Vert. Datum _____

LATITUDE _____ ELLIPS. HT. _____

LONGITUDE _____

NAD83(91) _____ NETWORK ADJ. YR _____

GPS (X) _____ TRAVERSE (X) _____

BASED ON THE FOLLOWING CONTROL:

CORNER MONUMENT WITNESS MONUMENT

BEARINGS ARE BASED ON: _____

FIELD BOOK _____ PAGE # _____ SHEET 1 OF 4

SHOW A PLAN VIEW DRAWING DEPICTING THE CORNER MONUMENT AND SURROUNDING PHYSICAL FEATURES, INCLUDING THE EXCAVATION AREA AND DEPTH.

PLANNING & ZONING COMMITTEE ADOPTED THIS FORM ON 12/2/1982

CORNER CODE E-5(1)

AV523


(B) Describe any record evidence, monument evidence, occupational evidence, testimonial evidence or any other material evidence you considered, and whether the monument was found or placed.

- 1834 HARRISON NORTH BET SECS 7 & 8
- 2640 QUARRTER SEC COR. NEAR N.E. EDGE OF PRAIRIE
{BUR O 12 N56E 509.52'
 - 3960 LEFT PRAIRIE
 - 5082 CREEK 13.2' CRS SW & ENTER BOTTOM
 - 5280 COR TO SECS 5,6,7,8 IN A BEND CREEK CRS S.E.
LAND 1ST 3/4 LEVEL 2ND RATE PRAIRIE, LAND 1/4
ROLLING & 2ND RATE WITH BURR OAK TIMBER.
EAST RAND. BET 5 & 8
 - 6.6 LEAVE BROOK CRS S.W.
 - 330 LEAVE BOTTOM
 - 2640 TEMPY 1/4 P
 - 5289.9 E BDG 138.6' N OR P [LAND LEVEL 2ND RATE TIMBER
RED O & BURR O
COR WEST
 - 2644.95 QUARTER SEC COR {RED O 18 S89W 45.54' RED O
10 N24E 69.96'
RED O 18 RED O 10} MARKED
 - 5289.9 SEC COR
WEST BET 6 & 7
 - 33 CREEK 13.2' CRS N.W.
 - 165 CREEK 13.2' CRS SOUTH
 - 726 LEFT BOTTOM
 - 2640 TEMPY 1/4 POST
 - 5294.52 INT. W. BDY 9.9' S OF POST LAND 1ST 1/2 LEVEL 2ND
RATE WITH BURR O TIMBER, 2ND 1/2 LEVEL 2ND RATE
PRAIRIE
COR EAST
 - 2647.26 QUARTER SEC COR {BURR O 10 S24W 45.54' BURR
OAK 8 N9E 79.86' BURR OAK 10 BUR OAK
8} MARKED
 - 5294.52 SEC COR.
NORTH BET 5 & 6
 - 19.8 LEAVE CREEK?
 - 528 LEAVE BOTTOM
 - 810.48 RED O 12
 - 1463.88 W.O. 24
 - 2572.68 BUR OAK 12
 - 2640 QUARTER SEC COR. BURR OAK 20 N82E 38.28'
BURR OAK 12 S86W 50.82' BURR OAK 20 BURR
OAK 12 } MARKED
 - 2904 BURR OAK 12
 - 4006.86 BURR OAK 10
 - 4664.22 INT. N BDY 96.36' EAST OF POST {BURR OAK 18
S26W 36.3' WHITE OAK 18 S63E 69.3' LAND
ROLLING 2ND RATE WITH BURR & WHITE OAK TIMBER
JAN 31 1834
- 1852 MC VEAN VOL 1 PG 9 2726.46 TO N 1/4 COR SEC 7 & 5319.6
TO SE COR SEC 7
- 1853 MC VEAN VOL 1 PG 18 2663.76 TO S 1/4 COR SEC 5
- 1874 RUGER VOL 2 PG 144 & MAP#M41 FD OLD STAKE IN CENTER
OF CREEK THE STAKE IS CLOSE TO FENCE POST SURROUNDED
STAKE WITH 4 LIMESTONES. VAR 5-41 2660.46 TO W 1/4 COR
SEC 8
- 1969 BATTERMAN VOL 4 PG 466 FD STONE SET CONC. MON.
- 1974 THOM MAP #M15002 FD CONC. MON. ANGLE OF 90-03-25 @
FD 2" PIPE S 1/4 COR SEC 6 FROM N/S 1/4 LINE SEC 6 TO SE
COR SEC 6
- 1975 SCHEENBERGER "ASSESSOR'S PLAT NO.1" BK 27 PG 27 FD
CONC. MON. 955.14' TO CENTER OF STH 81.
- 1981 LEE CSM 10 PG 297 FD CONC. MON. 2673.70 TO FD ALUM @
W 1/4 COR SEC 5.


SHEET 1 OF 4
CORNER CODE E-5(1)

Donald Barnes

6-06-2005

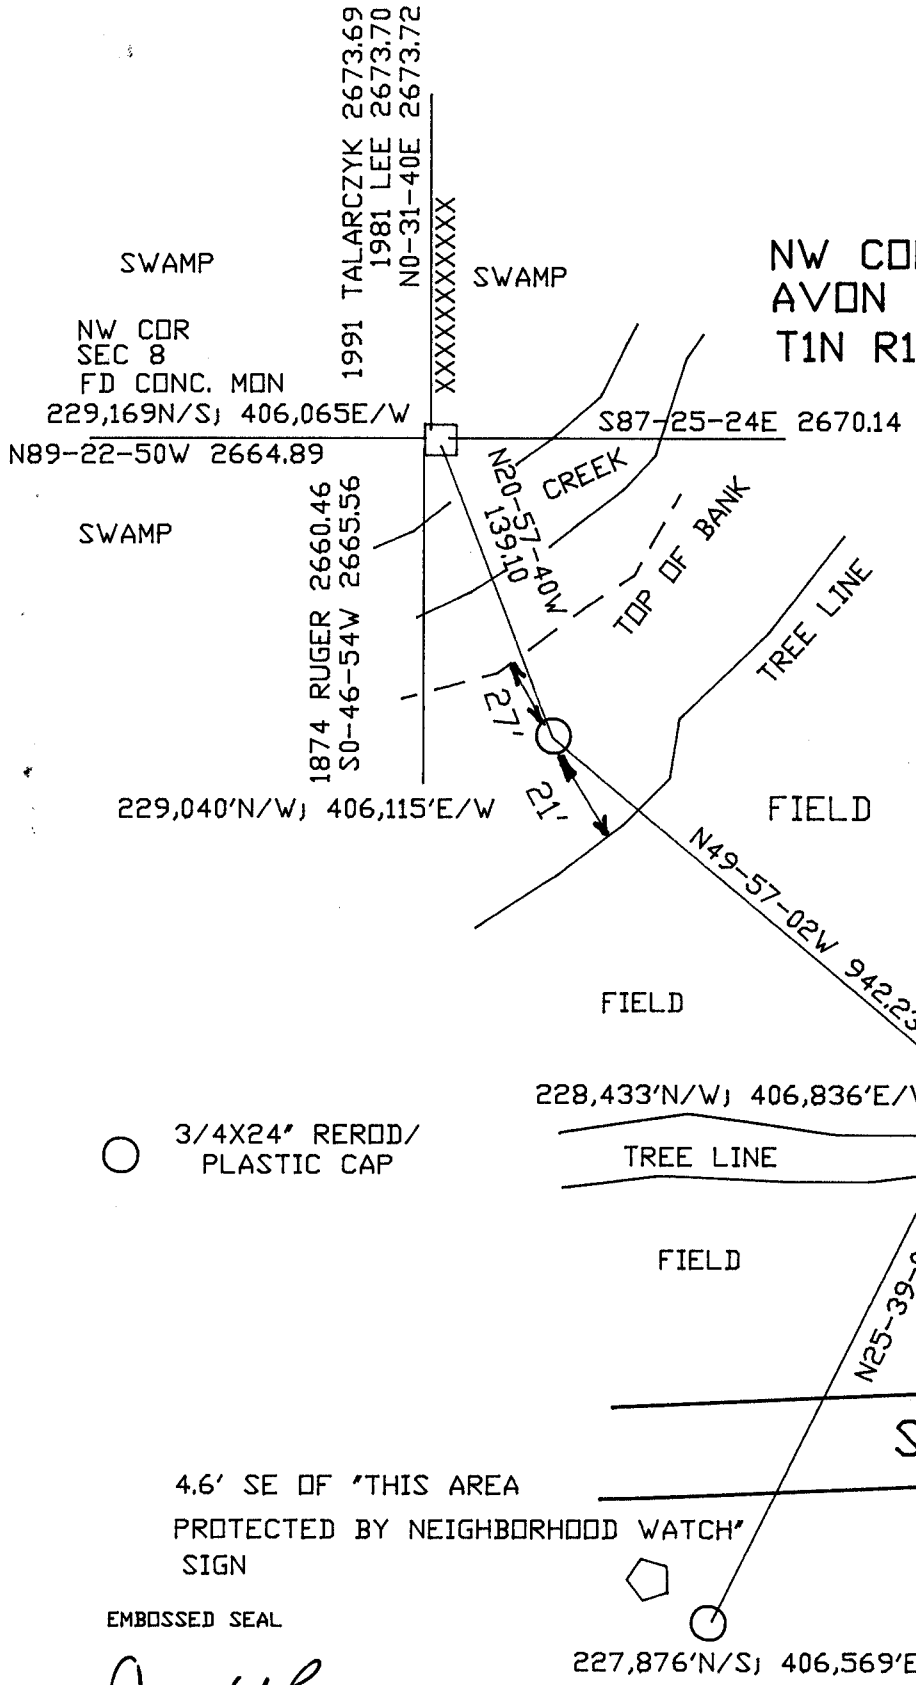

NW COR SEC 8
AVON TWP
T1N R10E

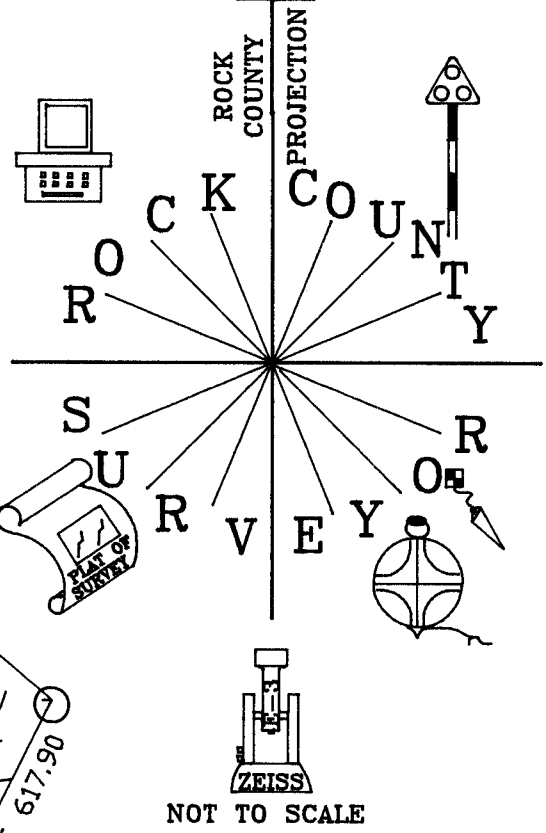

○ 3/4X24' REROD/
PLASTIC CAP



4.6' SE OF 'THIS AREA
PROTECTED BY NEIGHBORHOOD WATCH'
SIGN

EMBOSSED SEAL

Donald Barnes
6-06-05


SHEET 3 OF 4

E-5(1)

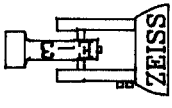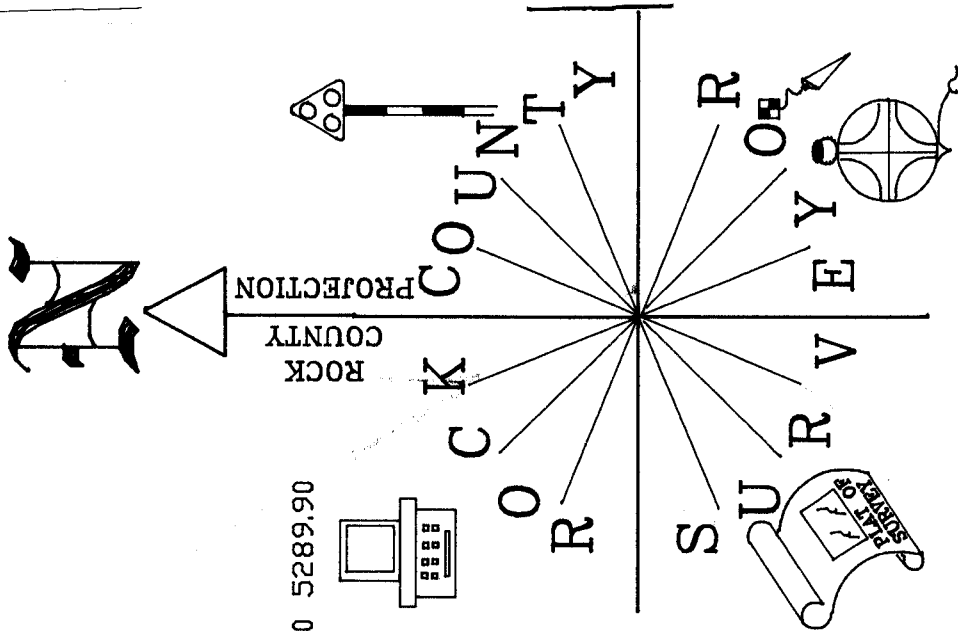

NOT TO SCALE

NEW OBSERVATION SHEETS &
OLD TRAVERSE OBSERVATIONS

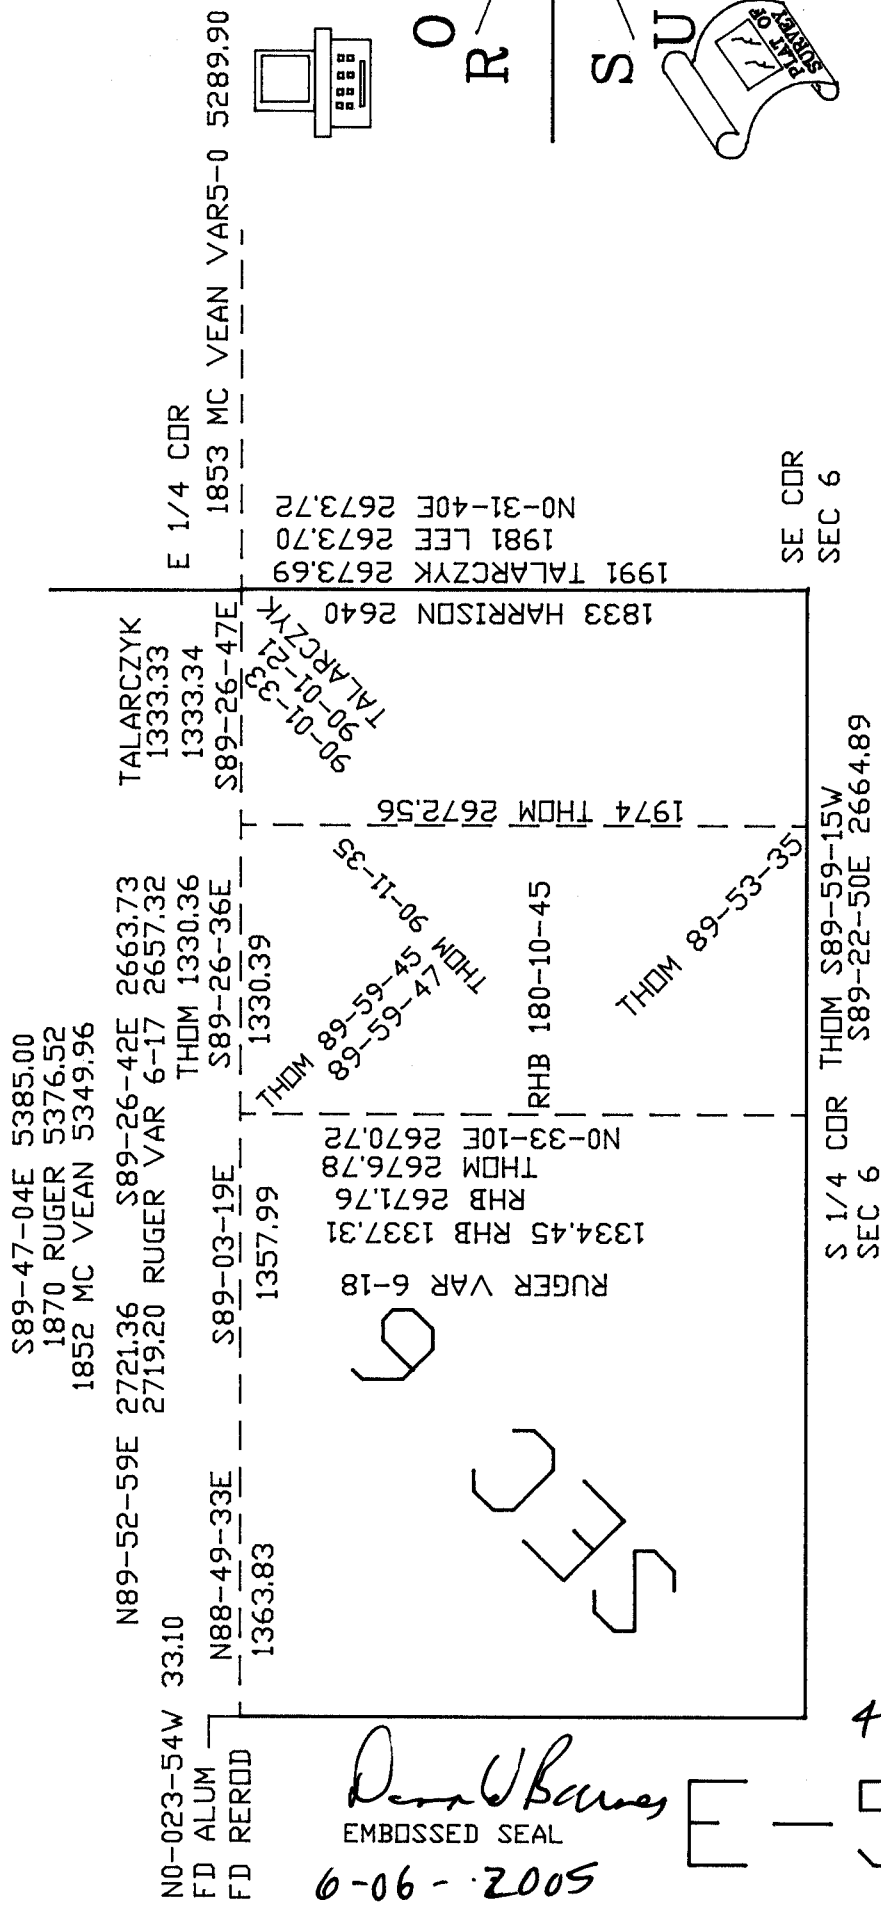

N0-023-54W 33.10
FD ALUM
FD REROD

Denn U. Bowers
EMBOSSED SEAL
6-06-2005

4 OF 4
E-5(1)