
U.S. PUBLIC LAND SURVEY MONUMENT RECORD

For Public Land Survey Corners in the T. 4 N., R. 14 E.

CORNER CODE INDEX

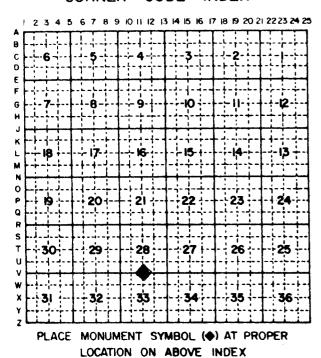

EXAMPLE

2 3 4 7 8 C/MA TWP

ROCK COUNTY W

IF AVAILABLE
STATE PLANE COORDINATES

North (Y) Eleve. (Z)

East (X) Zone


Hor. Datum Vert. Datum

(a.)

CORNER MONUMENT

O WITNESS MONUMENT

DOT

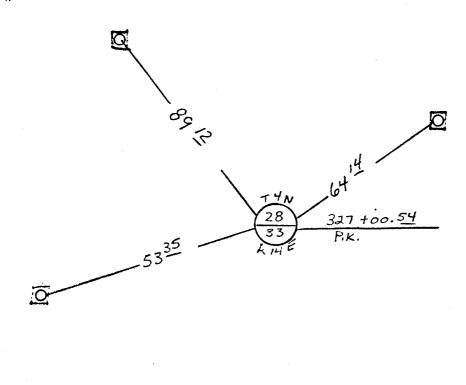

FIELD BOOK

PAGE #

SHOW A PLAN VIEW DRAWING DEPICTING THE CORNER MONUMENT AND SURROUNDING PHYSICAL FEATURES, INCLUDING THE EXCAVATION AREA AND DEPTH. THE CORNER MONUMENT SHALL HAVE THE FOLLOWING CHARACTERISTICS: I) HAVE AT LEAST TWO PREDETERMINED BREAK-OFF POINTS. 2) IF BROKEN, LEAVE A PERMANENTLY MAGNETIZED REMNANT AT THE ORIGINAL POINT. 3) MUST BE EXTENDABLE. 4) THE CAP IS INSCRIBED: ROCK COUNTY SURVEY MONUMENT - PENALTY FOR DISTURBING MARKER. 5) OR AN EXISTING CUT LIMESTONE. AN IRON PIPE 1/2" x 4'0" (MINIMUM) MAY BE USED IN AREAS WHERE GROUND WATER IS WITHIN ONE FOOT OF THE SURFACE. IF THE CORNER IS OCCUPIED BY AN IMPROVEMENT (MANHOLE, BURIED CABLE, ETC.) ANY DURABLE, DISTINCT MONUMENT MAY BE USED. CORNERS SHALL BE REFERENCED WITH AT LEAST 4 DURABLE WITNESS MONUMENTS. WITNESS MONUMENTS SHALL BE MADE OF CONCRETE, NATURAL STONE, IRON OR OTHER EQUALLY DURABLE MATERIAL, EXCEPT WOOD. DESCRIBE THE CORNER AND THE WITNESS MONUMENTS.

(b.)	Describe any record evidence, monument evidence, occupational evidence, testimonial evidence or		
	any other material evidence you considered, and whether the monument was found or placed.		
	•		
	·		
(c.)	Was the corner restored through acceptance of (1) an obliterated evidence location, or, (2) a found perpetuated location?		
	Tourn perpatuated Total Tour		
(d.)	Describe any material discrepancy between the location of the corner as restored or reestablished and the location of that corner as previously restored or reestablished by distance and direction. Show the discrepancy on the plan view drawing under (a),		
, ,			
	above. Show the distances between the corner as previously restored or reestablished and (1) the corner as restored or reestablished, and (2) to at least 4 of the witness		
	monuments shown on the drawing in (a), above.		
, ,			
(e.)	method, including the directions and distances to other public land survey corners used as		
	evidence or used for proportioning in determining the corner location,		
	I, hereby certify that the corner points		
	as identified by the corner code index were, in a field survey on, established, re-established, monumented, re-monumented, recovered or restored as expressed below and in conformance with the		
	regulations and rules as required in the current manual of survey		
	instructions of the United States Department of Interior. Bureau		
of Land Management.			
		COUNTY SURVEYOR FILING DATA	
	SEAL	Date of Computer Entry	
		Date Received Nov 20 1986	
		Date Microfilmed	
		Treasurer's Receipt No.	
		Number of Included Sheets	
	[
	CORNER		
		AFFIX YOUR LAND SURVEYOR SEAL. CODE V//	