## U.S. PUBLIC LAND SURVEY MONUMENT RECORD

For Public Land Survey Corners in For Miscellaneous Corners within <u>LIMA</u> TWP. T.4 N., R. 14 E. Sec. 28, T. 4 N., R. 14 E. CORNER CODE INDEX 2 3 4 1. Above code numbers are positioned Meander, Claim, or Fractional corners of the section. Township corner code numbers shall - 27 28 be applied to the corners of above typical section. EXAMPLE PLACE MONUMENT SYMBOL ( ) AT PROPER LOCATION ON ABOVE INDEX

IF AVAILABLE

STATE PLANE COORDINATES

284,262.24

North (Y) Eleve. (Z)

East (X2,306,249.01 Zone South

Hor. Datum Vert. Datum

EXAMPLE

2 3 4 Z-4 5

A-4

B

C


D

D-3/4

E-1/2

(a.) CORNER MONUMENT

O WITNESS MONUMENT

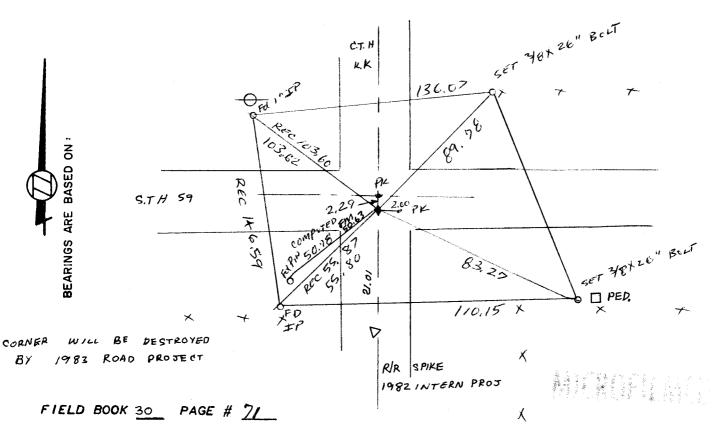

Describe any record evidence, monument evidence, occupational evidence, testimonial evidence or any other material evidence you considered, and whether the monument was found or placed. (b.)

FOUND PK NAIL 2.3' SOUTH OF CENTERLINE

(c.) Was the corner restored through acceptance of (1) an obliterated evidence location, or, (2) a found perpetuated location?

ACCEPTED FOUND PERPETUATED LOCATION.

(d.) Describe any material discrepancy between the location of the corner as restored or reestablished and the location of that corner as previously restored or reestablished by distance and direction. Show the discrepancy on the plan view drawing under (a), above. Show the distances between the corner as previously restored or reestablished and (1) the corner as restored or reestablished, and (2) to at least 4 of the witness monuments shown on the drawing in (a), above.

Was the corner reestablished through lost corner proportionate methods? If so, show the method, including the directions and distances to other public land survey corners used as evidence or used for proportioning in determining the corner location. (e.)

Donald Buris I, , hereby certify that the corner points as identified by the corner code index were, in a field survey on  $\frac{\delta_c \tau}{l}$  / 1982 , established, re-established, monumented, re-monumented, recovered or restored as expressed below and in conformance with the regulations and rules as required in the current manual of survey instructions of the United States Department of Interior, Bureau of Land Management.



COUNTY SURVEYOR FILING DATA	v
Date of Computer Entry	
Date Received	
Date Microfilmed 10/15/1984	
Treasurer's Receipt No.	
Number of Included Sheets	

AFFIX YOUR LAND SURVEYOR SEAL.  $\sqrt{q}$ 

