
U.S. PUBLIC LAND SURVEY MONUMENT RECORD

For Public Land Survey Corners in the 4ma 2 T. 4 N., R. 14 E.

CORNER CODE INDEX

For Miscellaneous Corners within Sec.

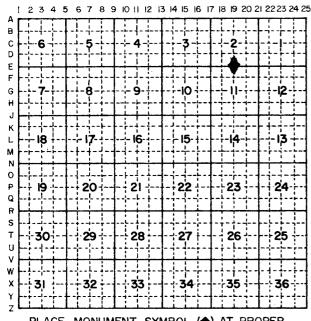


PLACE MONUMENT SYMBOL (•) AT PROPER LOCATION ON ABOVE INDEX

IF AVAILABLE STATE PLANE COORDINATES


North (Y) 304,002, // Eleve. (Z) 90/


East (X) 2,320,137.48 Zone South

Hor. Datum _____ Vert. Datum

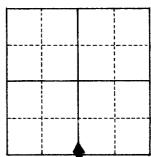

- . Above code numbers are positioned Meander, Claim, or Fractional corners of the section.
- Township corner code numbers shall be applied to the corners of above typical section.

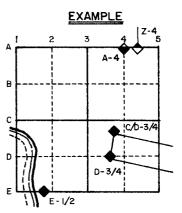

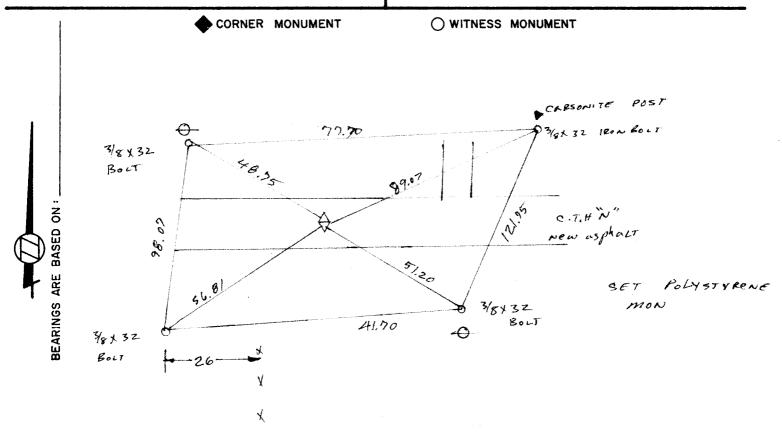

SHOW A PLAN VIEW DRAWING DEPICTING THE CORNER MONUMENT AND SURROUNDING PHYSICAL FEATURES, INCLUDING THE EXCAVATION AREA AND DEPTH. THE CORNER MONUMENT SHALL HAVE THE FOLLOWING CHARACTERISTICS: I) HAVE AT LEAST TWO PREDETERMINED BREAK-OFF POINTS. 2) IF BROKEN, LEAVE A PERMANENTLY MAGNETIZED REMNANT AT THE ORIGINAL POINT. 3) MUST BE EXTENDABLE. 4) THE CAP IS INSCRIBED: ROCK COUNTY SURVEY MONUMENT - PENALTY FOR DISTURBING MARKER. 5) OR AN EXISTING CUT LIMESTONE. AN IRON PIPE I 2 x 4'0" (MINIMUM) WITH AT LEAST 4 DURABLE WITNESS MONUMENTS MAY BE USED IN AREAS WHERE GROUND WATER IS WITHIN 1.0' OF THE SURFACE. IF THE CORNER IS OCCUPIED BY AN IMPROVEMENT (MANHOLE, BURIED CABLE, ETC.), ANY DURABLE, DISTINCT MONUMENT MAY BE USED AND REFERENCED WITH AT LEAST 4 DURABLE WITNESS MONUMENTS.

CORNER CODE: E-19

Fov	NP TIES	A5	SET	PRIOR	70	Road	CONSTRUCT
					Andrew Committee Com		
	-						
corner	e any mater as restored as previous	d or re-	-estab	lished a	nd the	location	
	one						
againe and the second s		٢٠٠ (١٩٠٠) والمنافق المنافقة والمنافق المنافق المنافق المنافق المنافقة المن				النويون في المستقل و	· · · · · · · · · · · · · · · · · · ·
	corner res		_				iterated
	· cepted	TIES					
methods distanc	? If so, sees to other	show the public	e meth c land	od, incl survey	uding corner	directions used as	
					,		
,(),	nold ba	the corr	ner co	de index	were,	in a fi	corner point
as iden	1982 , es ed or resto ions and ru	ored as ules as ne Unite	expre requi	ssed bel red in t	ow and hė cur	in conforent man	ormance with
as iden	1982 , esections and rutions of the	ored as ules as ne Unite	expre requi ed Sta	ssed bel red in t tes Depa	ow and hè cur rtment	in conforent man	ormance with ual of survey rior, Bureau
as iden	1982 , esections and rutions of the	ored as ules as ne Unite	expre requi ed Sta	ssed bel red in t tes Depa	ow and he cur rtment VEYOR	in conforent many of Inter	ormance with ual of survey rior, Bureau
recover regulations	ed or restorions and rutions of the Management	ored as ules as ne Unite	expre requi ed Sta CO Da	ssed bel red in t tes Depa UNTY SUR te of Co te Recei	ow and he cur rtment VEYOR mputer ved	in conforent many of Inter	ormance with ual of survey rior, Bureau
as iden recover regulat instruc of Land	ed or restorions and rutions of the Management DONALD A. BARNES S-1216	ored as ules as ne Unite	expre requi ed Sta CO Da Da	ssed bel red in t tes Depa UNTY SUR te of Co te Recei te Micro	ow and he cur rtment VEYOR mputer ved filmed	in conforent many of Interpretation	ormance with ual of survey rior, Bureau
as iden	ed or restorions and rutions of the Management DONALD A. BARNES	ored as ules as ne Unite	expre requi ed Sta CO Da Da Da Tr	ssed bel red in t tes Depa UNTY SUR te of Co te Recei te Micro easurer	ow and he cur rtment VEYOR mputer ved filmed s Rece	in conforent many of Interpretation of Interpret	ormance with ual of survey rior, Bureau
recover regulatinstruc of Land	ed or restorions and rutions of the Management DONALD A. BARNES S-1216 JANESVILLE	ored as ales as ne Unite	expre requi ed Sta CO Da Da Da Tr	ssed bel red in t tes Depa UNTY SUR te of Co te Recei te Micro easurer	ow and he cur rtment VEYOR mputer ved filmed s Rece	in conforent many of Interpretation	ormance with ual of survey rior, Bureau

AFFIX YOUR LAND SURVEYOR SEAL. E19