
U.S.

PUBLIC LAND SURVEY MONUMENT RECORD

For Public Land Survey Corners in: T. \(\sum_N \), R. \(\frac{9}{E} \)

CORNER CODE INDEX

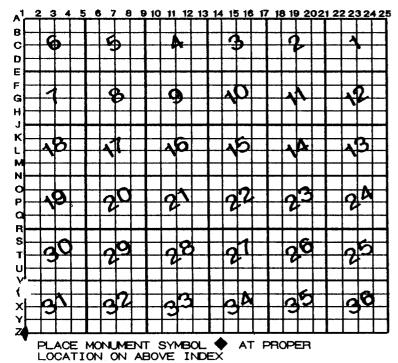

WI ADMINISTRATIVE CODE A-E 7.08 REQUIREMENT

SPRING GROVE

TWP

ROCK COUNTY WI

IF AVAILABLE

ROCK COUNTY COORDINATES PERFERRED

North 202,634,684 Elev. 828,015

East 400, 817, 721

Hor. Datum NAD 83 Vert. Datum NAD 29

LATITUDE 42-30-0,308922 ELLIPS. HT.

LONGITUTE 89-21-56,97699/ 7/9,009

GPS (X) $\frac{\chi}{\lambda}$

TRAVERSE (X) ___

BASED ON THE FOLLOWING CONTROL:

◆CORNER MONUMENT

O WITNESS MONUMENT

(a)

BEARINGS ARE

Fd ALUM MON

SE 36 TIR9E

THE ABOVE LATITUDE & LONGITUDE WAS ACQUIRED FOR A GREEN COUNTY LAND INFORMATION PROJECT BY BOWEDEN SURVEYING COMPANY. GPS EQUIPMENT WAS USED. BOWEDEN SURVEYING COMPANY PROVIDED THE INFORMATION.

I COMPUTED THE COUNTY COORDINATES AND THE FOLLOW DATA FROM THE BASED LATITUDE & LONGITUDE.

SCALE /.000003/63/

ANGULAR DIFFERENCE BETWEEN THE GEODETIC NORTH & ROCK COUNTY MERCATOR NORTH

0-11-54,09

PAGE # SHOW A PLAN VIEW DRAWING DEPICTING THE CORNER MONUMENT AND SURROUNDING

PHYSICAL FEATURES, INCLUDING THE EXCAVATION AREA AND DEPTH. AVON PLANNING & ZONING COMMITTEE ADOPTED THE ABOVE FORM ON 12/2/1982

CORNER CODE

(B) Describe any record evidence, monument evidence, occupational evidence, testimonial evidence or any other material evidence you considered, and whether the monument was found or placed.

I DID NOT PERFORM THE SURVEY. I AM ONLY PLACING ON RECORD THE DATA.

Was the corner restored through acceptance of (1) an obliterated evidence location, or, (2) a found perpetuated location?

DID NOT ACCEPT NOR REJECT THE PROVIDED DATA.

- D) Describe any material discrepancy between the location of the corner as restored or reestablished and the location of that corner as previously restored or reestablished by distance and direction. Show the discrepancy on the plan view drawing under (a), above. Show the distances between the corner as previously restored or reestablished and (1) the corner as restored or reestablished, and (2) to at least 4 of the witness monuments shown on the drawing in (a), above.
- (E) Was the corner reestablished through lost corner proportionate methods? If so, show the method, including the directions and distances to other public land survey corners used as evidence or used for proportioning the corner location.
- I, Donald Barnes, hereby certify that the corner location as identified by the corner code index was determined by me under by direction and control and that this U.S. Public Land Survey Monument Record is correct and complete to the best of my knowledge and belief.

seal

Donal Bounes
emboss

725/95 A-E 7.08 REQUIREMENT

Number of included sheets

CORNER CODE

AVON TWP