
## U.S. PUBLIC LAND SURVEY MONUMENT RECORD

For Public Land Survey Corners In:

WI ADMINISTRATIVE CODE A-E 7.08 REQUIREMENT

T.  $\angle N$ . R.  $\angle o$  E.

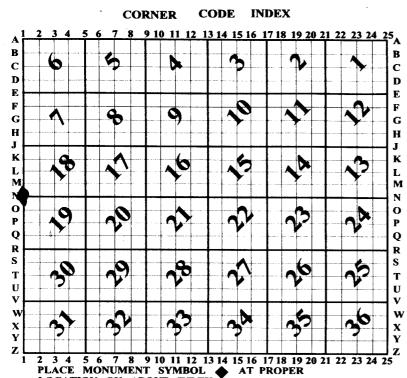

ROCK COUNTY WI

IF AVAILABLE
ROCK COUNTY COORDINATES PERFERRED

North	Elev.
East	
Hor. Datum _	Vert. Datum
LATITUDE	ELLIPS. HT
LONGITUDE	

BASED ON THE FOLLOWING CONTROL:

GPS (X) \_\_\_\_ TRAVERSE (X) \_\_

LOCATION ON ABOVE INDEX

AT PROPER

CORNER MONUMENT

**O WITNESS MONUMENT** 

BEARINGS ARE BASED ON:\_\_\_\_\_\_\_

(a)

## AV561

- (B) Describe any record evidence, monument evidence, occupational evidence, testimonial evidence or any other material evidence you considered, and whether the monument was found or placed.
- 1833 (MAY) HARRISON VAR 8 E NORTH ON EAST SIDE OF SEC 24 3<sup>RD</sup> MILE T1N R9E
  - 2640 SET A POST & RAISED A MOUND FOR COR TO 1/4
    SEC IN BOTTOM OF CREEK
  - 5280 SET A POST FOR COR TO SECS 13 & 24 POST & RAISED MOUND. LAND LEVEL & PARTIALLY WET. 2<sup>ND</sup> RATE. THE GROWTH IN THE BOTTOM OF THE CREEK WHERE IT IS NOT TOO WET IS A HIGH GRASS WELL ADAPTED FOR CUTTING HAY AND PASTURAGE

NORTH ON E SIDE OF SEC 13 4TH MILE

- 2211 INT. SUGAR CREEK CRS E AND SET A POST FOR MEANDERING CORNER FROM WHICH A RED OAK 18 INCHES IN DIAM. BEARS S66E 206.58' DIST. LAND & C? SAME.
- 1833 (SEP) MULLETT & BRINK VAR 8 EAST BEGUN A POST ON RIGHT BANK OF SUGAR CREEK, EAST SIDE OF SEC 13. NORTH ON EAST SIDE OF SEC 13, WHICH IS
  - 2211 FROM CORNER TO SECTIONS 13 x 24
  - 2393.82 SET POST ON LEFT BANK SUGAR CREEK W.
    ASH 6 S23E DIST 55.44' BURR OAK 14 N48W
    237.6'
  - 2640 SET  $\frac{1}{4}$  SEC POST BUR DAK 16 NB  $\frac{1}{2}$  W 63.36' ND DTHER
  - 3069 BUR DAK 12
  - 4620 ENTER PRAIRIE
  - 5280 SET DAK POST FOR CORNER TO SECTIONS 12 & 13
    RAISED A MOUND. LAND LEVEL, 2<sup>ND</sup> RATE. FIRST
    PART THINLY TIMBERED WITH BUR DAK
- 1833 (MARCH) HARRISON WEST BET SEC 18 & 19 T1N R10E
  - 2640 SET POST & RAISED A MOUND FOR COR TO 1/4 SEC
  - 5214 INT. WEST BDY AT POST LAND &? SAME CLOSED SUBDIVISION OF THIS TOWNSHIP MARCH 17<sup>TH</sup> 1833 GEORGE HARRISON.
- 1852 MC VEAN MAP #00066 SUBDIVIDED SECTION. MAP SHOWS
  THE MONUMENTS HE PLACED AT THE INTERIOR CORNERS
  BUT DOES NOT CALL FOR DISTANCES. E/W ¼ LINE IS A VAR
  OF 6 ½ THE DISTANCE FROM THE CENTER OF SEC 18 TO
  THE MP ON THE NORTH BANK OF SUGAR RIVER (ON BANK
  OF RIVER, CHERRY 10 N59 ½ W 168.96' ALSO YELLOW OAK
  10 N16 ½ E 102.96') & ON THE N/S ¼ LINE.
- 1902 MORGAN GREEN COUNTY SURVEYOR MAP #80000 A LETTER WITH A MAP ON THE MAP WHICH APPEARS FROM THE CORRESPONDENCE TO BE KERCH'S MAP & FIELD COMPUTATIONS. MAP CALLS FOR THE USE OF A RANDOM LINE AT A 90 ANGLE FROM THE NORTH LINE OF THE NW ¼ OF SEC 18. ANGLE OF 89-11 AT THE NW COR SEC 18 FROM THE N ¼ COR SEC 18 TO THE W ¼ COR SEC 18 WAS COMPUTED AND NOT OBSERVED DIRECTLY.
- 1902 MORGAN GREEN COUNTY SURVEYOR MAP #80002 ON BACK OF LETTER IS STATEMENT "LINE 66 FT WEST OF SW COR. 1295 F 1/4 1/4 FENCE. 2654.
- 1902 KERCH FB #2 PG 3. MAP OF SEC 18 & NOTES OF MONUMENTS FOUND. VERY DIFFICULT TO READ.
- 19?? KERCH VOL 3 PG 19 2588.0 TO 5 1/4 COR SEC 18. STATES NOTHING ABOUT CORNER
- 1972 LEE VOL 4 PG 555 SET CI & REFERENCED SAME. DOES NOT STATE WHAT HE FOUND NOR HOW HE ESTABLISHED IT. FB #163 PG 23 JUST SHOWS TIES.
- 1975 BICKLE MAP #100 2604.34 TO 5 ¼ COR SEC 18, 2653.34TO \* W ¼ COR SEC 19 & ANGLE OF 88-07-02 AT SW COR SEC 18 FROM 5 ¼ COR SEC 18 TO W ¼ COR SEC 19

SHEET 1 OF 2

CORNER CODE N-1

Durdd Barnes

## AV561

- 1977 BARNES VOL 5 PG 292, 292 & 300 2604.36 TO 5 1/4 COR SEC 18. FD CI ANGLE 92-14-36 @ SW COR SEC 18 FROM NW COR SEC 18 TO S 1/4 COR SEC 18. FD NE, NW, & S REFERENCE PIPES.
- 1977 BARNES VOL 5 PG 300 2677.25 TO NW COR SEC 18.
- 1978 TALARCZYK MAP #00068 TIE SHEET. CALLS FOR THE CORNER TO BE COMMON FOR SEC 13,24,18 & 19 CORNER SET BY PROPORTIONATE MEASUREMENT & EXISTING PHYSICAL EVIDENCE. LEGEND CALLS FOR ALUM. MON. REFERENCED CORNER. CALLS FOR MON. 4' NORTH OF E/W CENTER PVMT, & WEST OF WEST PVMT EDGE. TOP OF MONUMENT 4" BELOW GRADE.
- 1995 WPL N-1 COORDINATES SUPPLIED BY WPL. THE SURVEY WAS BY GPS AND CONNECTED TO THREE ROCK COUNTY GPS CONTROL GPS CONTROL MONUMENTS: BRODHEAD, (3055), AVON (3125), AND NEWARK EAST (3136) NADB3(91) WI STATE PLANE COORDINATES, SOUTH ZONE. US SURVEY FEET. 198.34.418' N/S 2,139,303.087' E/W. CONVERTED 218,549.76 N/S; 400,764.82 E/W
- 2002 BATTERMAN COUNTY COORDINATES OF 218,549.69 N/S; 400,764.776 E/W
- FD CI. 17' WEST OF N/S CENTER OF PVMT, 5' NORTH OF CENTER PVMT PROJECTED FROM WEST & 1.5' NORTH OF CENTER OF PVMT PROJECTED FROM EAST. SO-11-32E 2653.39 TO W ¼ COR SEC 19, S88-18-34E 2604.39 TO 5 ¼ COR SEC 18, NO 31-44E 5363.30 TO NW COR SEC 18. MORGAN'S & KERCH'S MAPS & LETTERS INDICATE A STRAIGHT LINE FROM THE NW COR SEC 18 & THE W 1/4 COR SEC 18 IS 66 WEST OF THE SW COR SEC 18 AND THERE IS BEND IN THE WEST LINE OF SEC 18.
- C) Was the corner restored through acceptance of (1) an obliterated evidence location, or, (2) a found perpetuated location?
- THE CORNER NEEDS TO BE DUG FOR. IT IS PROBABLE 15.5 TO 16.5' FARTHER EAST.
- D) Describe any material discrepancy between the location of the corner as restored or reestablished and the location of that corner as previously restored or reestablished by distance and direction. Show the discrepancy on the plan view drawing under (a), above. Show the distances between the corner as previously restored or reestablished and (1) the corner as restored or reestablished, and (2) to at least 4 of the witness monuments shown on the drawing in (a), above.
- (E) Was the corner reestablished through lost corner proportionate methods? If so, show the method, including the directions and distances to other public land survey corners used as evidence or used for proportioning the corner location.
- I, Donald Barnes, hereby certify that the corner location as identified by the corner code index was determined by me under my direction and control and that this U.S. Public Land Survey Monument Record is correct and complete to the best of my knowledge and belief.

SHEET 2 OF 2

Donal Burnes Oct 1 2002